

Subject: National Competitive Bidding for Fabrication, Transportation, Installation, Testing, and Commissioning of Quick Pontoon Opening Mechanism (QPOM) Comprising of Self-Propelled Pontoons in the state of Uttar Pradesh (01- Ballia District) and Bihar (01-Patna District).

IFB No: IN-IWAI-341909-GO-RFB

CPP Portal Ref: 2023_JMVP_750094_1

Amendment – 2

Amendment triggered due to Pre-bid responses

S. No.	Bid document Section, Clause	As per Bidding Documents	Amended
1.	BDS, ITB 41.1, Page No 43	ITB 41.1: The maximum percentage by which quantities may be increased is: 15% The maximum percentage by which quantities may be decreased is: 15%	The same be read as follows: ITB 41.1: The maximum percentage by which quantities may be increased is: Nil The maximum percentage by which quantities may be decreased is: Nil
2.	ITB 32.1(b), Page No 45 to 46.	The bidder should have experience of supply & commissioning of one (01) similar item in the last 5 years. “Supply and commissioning of similar items” means Fabrication, Transportation, Testing and Commissioning of self-propelled/ non propelled barges/ vessels /moored barges duly certified by any classification society or registering authorities under Inland Vessel Act or any other relevant act / regulation”	The clause may be read as: <i>The bidder should have experience of supply & commissioning of one (01) similar item in the last 5 years “Supply and commissioning of similar items” means Fabrication, Transportation, Testing and Commissioning of self-propelled/ non propelled barges/ vessels /moored barges duly certified by any classification society and registered by any registering authorities under Inland Vessel Act or any other relevant act / regulation”.</i>
3.	Clause no 2, Objective, Page No 81	The design has been carried out by Department of Naval Architecture and Ocean Technology, Indian Institute of Technology Kharagpur.	The same may be read as follows: IRS appraised detailed drawings prepared by CICMT, Indian Institute of Technology Kharagpur are attached herewith as Annexure-1 for Mooring barge and Main barge for ready reference. The bidders to adhere the technical specifications mentioned in the tender documents.

4.	Clause no 3.1, point no 15, Page No 83	As a passenger ferry can carry a maximum of 16 loaded matador vans (8 port and 8 starboard) + 600 (300 port + 300 passengers) passengers at a time.	<p>The clause may be read as: <i>As a passenger ferry, it should be capable of carrying a maximum of 16 loaded matador vans (8 port and 8 starboard) and 100 passengers at any given point of time</i></p>																		
5	Clause no-7b of Technical Specifications, Page no 94	Clause 7(b): “In the ferry mode, the economic speed should be about 7 to 8 knots in still water without shallow water effect and the maximum speed 8.5 knots at 92% MCR of the propulsion units”.	<p>The clause may be read as: <i>The economic speed should be about 7 to 8 knots in still water without shallow water effect.</i></p>																		
6	Clause no- 21d, Page No- 97	Clause No 21(d): “In the ferry mode, the economic speed should be about 7 to 8 knots and the maximum speed 9 knots at 92% MCR of the propulsion units.”	<p>The clause may be read as: <i>The maximum speed as 8.5 knots at 92% MCR of the propulsion units.</i></p>																		
7	Clause no 30, Page No 99	Adequate firefighting, Life-saving appliances, and Light and sound signals as per class rules are to be provided.	<p>The clause may be read as: <i>Adequate firefighting, Life-saving appliances, and Light and sound signals as per class rules are to be provided as per IV/IRS Rule 2022</i></p>																		
8	SCC, GCC 16.1, Page No 133 & 134	<p>Mobilization payment: 10% of the total contract amount to be paid within thirty (30) days of signing of Contract and upon submission of claim / against a simple receipt and a bank guarantee for the equivalent amount valid until the completion of the contract, in the form, provided in the bidding documents or another form acceptable to the Purchaser. The mandatory documents such as work methodology, work schedule, QAP and insurance document are also required to be submitted by the Supplier with the claim.</p> <p>II. Payment schedule of 65% of the total contract amount as per the below milestones:</p> <table border="1" data-bbox="526 1193 1234 1380"> <thead> <tr> <th data-bbox="526 1193 622 1380">Sr No</th> <th data-bbox="622 1193 920 1380">Milestones / Key Deliverables</th> <th data-bbox="920 1193 1234 1380">Payment Schedule (to be paid on prorata basis as per the Price Schedule-Supply)</th> </tr> </thead> <tbody> <tr> <td data-bbox="526 1273 622 1342">a</td> <td data-bbox="622 1273 920 1342">Completion of Keel Laying with certification of EIC.</td> <td data-bbox="920 1273 1234 1342">10%</td> </tr> <tr> <td data-bbox="526 1342 622 1380">b</td> <td data-bbox="622 1342 920 1380">Completion of 50% of Hull</td> <td data-bbox="920 1342 1234 1380">20%</td> </tr> </tbody> </table>	Sr No	Milestones / Key Deliverables	Payment Schedule (to be paid on prorata basis as per the Price Schedule-Supply)	a	Completion of Keel Laying with certification of EIC.	10%	b	Completion of 50% of Hull	20%	<p>The payment schedule has been clarified & may be read as follows:</p> <p>I. Mobilization payment: 10% of the total contract amount to be paid within thirty (30) days of signing of Contract and upon submission of claim / against a simple receipt and a bank guarantee for the equivalent amount valid until the completion of the contract, in the form, provided in the bidding documents or another form acceptable to the Purchaser. The mandatory documents such as work methodology, work schedule, QAP and insurance document are also required to be submitted by the Supplier with the claim.</p> <p>II. <i>Payment schedule for fabrication work at Supplier’s yard is as per the below milestones:</i></p> <table border="1" data-bbox="1265 1157 2190 1380"> <thead> <tr> <th data-bbox="1265 1157 1361 1268">Sr No</th> <th data-bbox="1361 1157 1854 1268">Milestones / Key Deliverables</th> <th data-bbox="1854 1157 2190 1268">Percentage on contract Amount</th> </tr> </thead> <tbody> <tr> <td data-bbox="1265 1268 1361 1342">a</td> <td data-bbox="1361 1268 1854 1342">Completion of Keel Laying with certification of EIC.</td> <td data-bbox="1854 1268 2190 1342">10%</td> </tr> <tr> <td data-bbox="1265 1342 1361 1380">b</td> <td data-bbox="1361 1342 1854 1380">Completion of 50% of Hull</td> <td data-bbox="1854 1342 2190 1380">20%</td> </tr> </tbody> </table>	Sr No	Milestones / Key Deliverables	Percentage on contract Amount	a	Completion of Keel Laying with certification of EIC.	10%	b	Completion of 50% of Hull	20%
Sr No	Milestones / Key Deliverables	Payment Schedule (to be paid on prorata basis as per the Price Schedule-Supply)																			
a	Completion of Keel Laying with certification of EIC.	10%																			
b	Completion of 50% of Hull	20%																			
Sr No	Milestones / Key Deliverables	Percentage on contract Amount																			
a	Completion of Keel Laying with certification of EIC.	10%																			
b	Completion of 50% of Hull	20%																			

		a	Completion of Keel Laying with certification of EIC.	10%			fabrication at the Supplier's yard after certification by EIC & any classification society as per Inland Vessel act.		
		b	Completion of 50% of Hull fabrication at the Supplier's yard after certification by EIC & any classification society as per Inland Vessel act.	20%			c	Completion of 100% of Hull fabrication at the Supplier's yard after certification by EIC & any classification society as per Inland Vessel act.	20%
		c	Completion of 100% of Hull fabrication at the Supplier's yard after certification by EIC & any classification society as per Inland Vessel act.	20%			d	Successful launching. Testing and Trail run of the complete units at Supplier's yard (as per Price Schedule) after certification of EIC & any classification society.	15%
		D	Successful launching. Testing and Trail run of the complete units at Supplier's yard (as per Price Schedule) after certification of EIC & any classification society.	15%			III. <i>Payment schedule for Transportation from Supplier's yard to respective site as per the below milestones:</i>		
		III. Payment schedule of 20% of the total contract amount as per the below milestones:					Sr No	Milestones / Key Deliverables	Percentage on contract Amount
							e	Successful transportation from Supplier's yard to the respective site (as per Price Schedule) and satisfactory installation of the same with certification by EIC & any classification society including submission of SOP/ Manual for Operation of the unit and training of purchaser's personnel in Train the Trainer Mode.	10%
							f	Testing, commissioning, and trial of the complete units at the respective site (as per Price Schedule) along	10%

Sr No	Milestones / Key Deliverables	Payment Schedule (to be paid on prorata basis as per the Price Schedule-Supply)	with the certification, any classification society & EIC including registration of the units in the name of the purchaser.
f	Successful transportation from Supplier's yard to the respective site (as per Price Schedule) and satisfactory installation of the same with certification by EIC & any classification society including submission of SOP/ Manual for Operation of the unit and training of purchaser's personnel in Train the Trainer Mode.	10%	<p>IV. On Final acceptance: 5% of the contract amount shall be paid within thirty (30) days after the date of the Acceptance Certificate issued by EIC in the proforma given in Section VII.</p> <p><i>All the percentages mentioned in the tables above (serial number I, II, III & IV) shall be calculated on the total contract amount.</i></p>
g	Testing, commissioning, and trial of the complete units at the respective site (as per Price	10%	

		<p>Schedule) along with the certification, any classification society & EIC including registration of the units in the name of the purchaser.</p>		
<p>IV. On Final acceptance: 5% of the contract amount shall be paid within thirty (30) days after the date of the Acceptance Certificate issued by EIC in the proforma given in Section VII.</p>				
<p>All other terms and conditions shall remain unaltered</p>				



IRCLASS
Indian Register of Shipping
CIN: U61100MH1975NPL018244

52 A, Adi Shankaracharya Marg, Opp. Powai Lake,
Powai, Mumbai - 400 072, India
Phone : +91 22 30519400 / +91 22 7119 9400
Fax : +91 22 2570 3611
E-mail : ho@irclass.org ★ Website : www.irclass.org

Our ref: E-166771-222116

05-October-2022

Company : Centre For Maritime & Coastal Maritime Technology

Dear Sir/Madam,

Your document (detailed below) has been reviewed.

Project Details	
Project number	MI001158
Project name	Design App – Main Barge (Kulfi System for IWAI)
Project Manager	Ankur Anal
Project In-Charge	Amit Waje

Document Details	
Plan No.	CICMT/IWAI/KULFI1/7
Plan Title	FRAMING SECTIONS 19 MAY2022-Model
Rev.No.	1
Upload.No.	1
Submitted Date	25-September-2022
Review Status	Reviewed
Parent Plan Title	

The plan has been examined for compliance with:

- . IRS Rules
Rules and Regulations for the Construction and Classification of Inland Waterways Vessels, July 2022

Notes

1. The review status Reviewed indicates:
The stated plan has been Reviewed against appropriate Regulations/Codes/Standards.
2. The list of remarks is part of this letter. Please address these comments by reply to us.


Thanking you,
Yours Sincerely,

For INDIAN REGISTER OF SHIPPING


Amit Gandhi
Senior Surveyor

This is an electronically published document and does not require signature.


Review Comments			
Sr.No	Comment Date	Description	Clearing Responsibility
1	05-October-2022	Plans to be resubmitted for our final endorsement after finalization of shipyard.	For Info
2	05-October-2022	Deckhouse and it's local reinforcement is reserved. Details of the same are to be submitted in deckhouse plan including all scantlings and plan/profile views.	Head Office
3	05-October-2022	Amendments indicated in the plan to be duly incorporated.	For Info
4	05-October-2022	Plan is reviewed considering following loads: 1. Maximum axle load on Deck= 0.75T, Number of load area per axle =2, Tyre print area = 300 mm x 150 mm 2. Live load on Deck = 500 kg/m2 Should there be change in above design loads, plan need to be re-examined.	For Info
5	05-October-2022	Plate thickness indicated in the plan are not consistent with approved copy of Midship Section Plan (Dwg. No : CICMT/IWAI/KULFI1/5, REV.1) Accordingly, we have considered plate thickness indicated in Midship Section during approval of this drawing. Designer is requested to amend the plate thickness as per Midship Section Plan.	Head Office
6	05-October-2022	Transverse Section at Fr.2 & 64 indicated in the plan is not matching with General Arrangement/Deck & Profile plan. Designer is requested to correct the sectional view.	Head Office

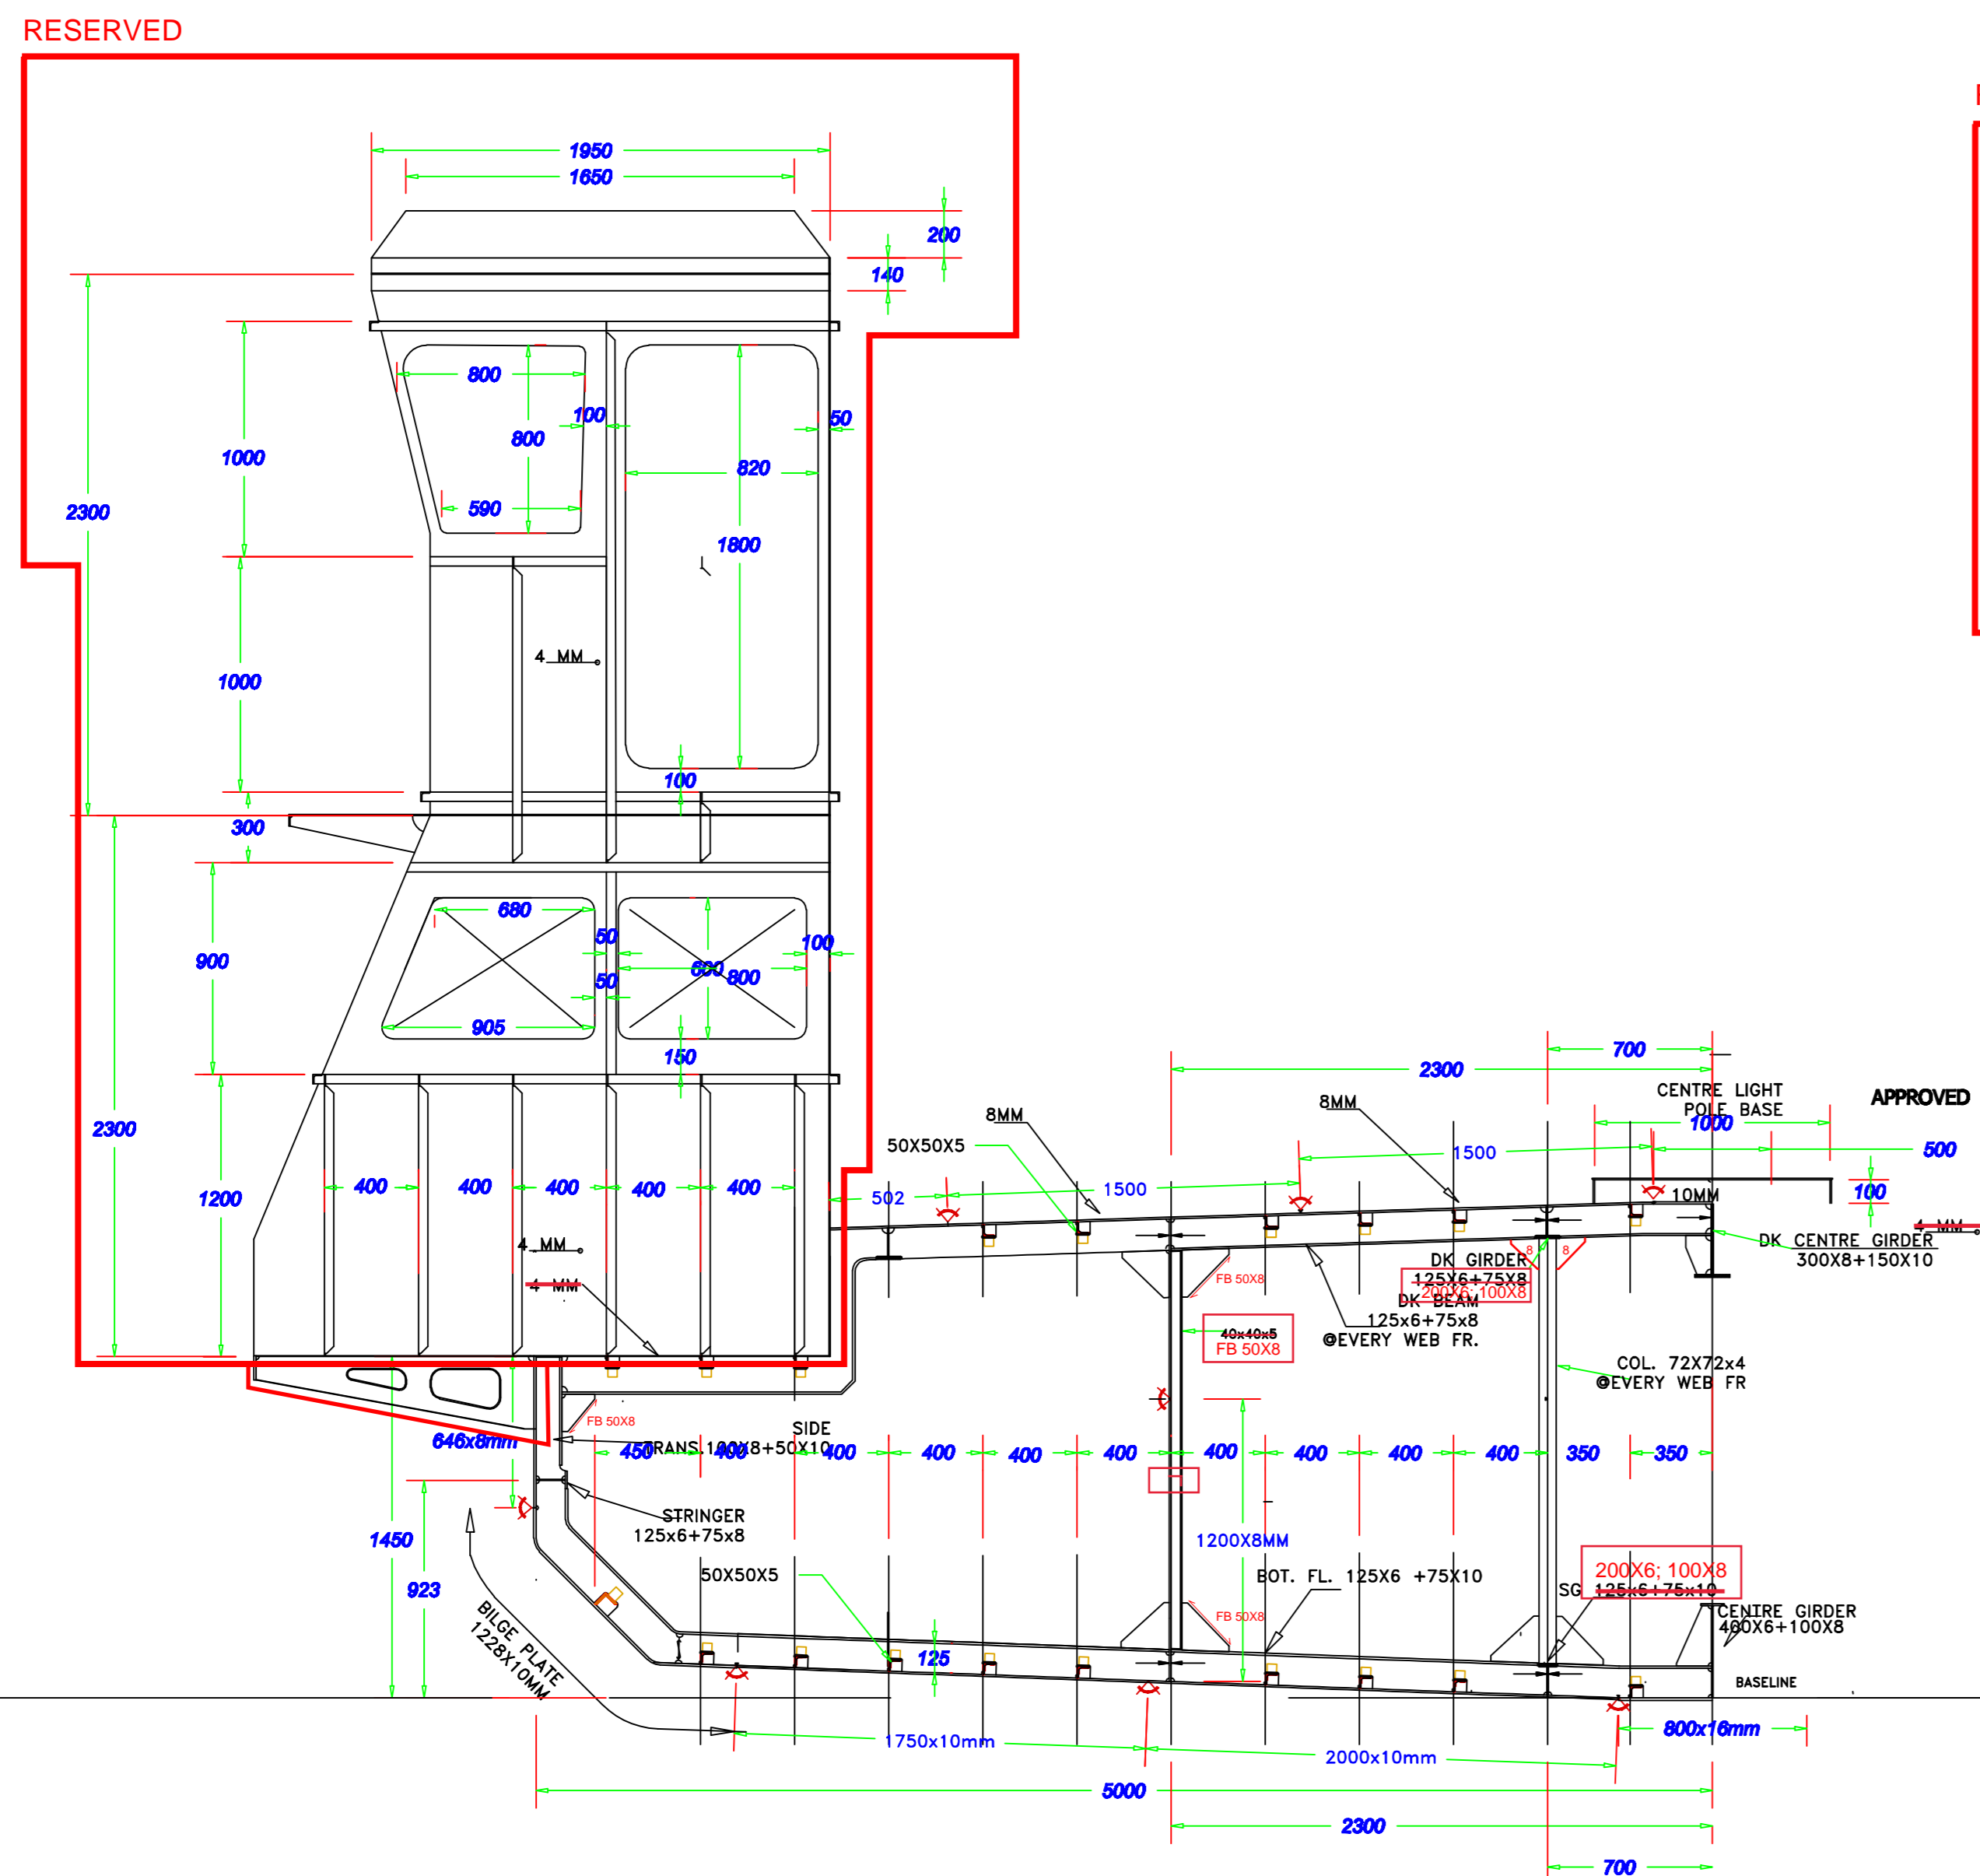


SECTION IN WAY OF FRAME 24 LOOKING FORD
(PORT SHOWN STBD SAME AS FRAME 30)
SCALE 1:25

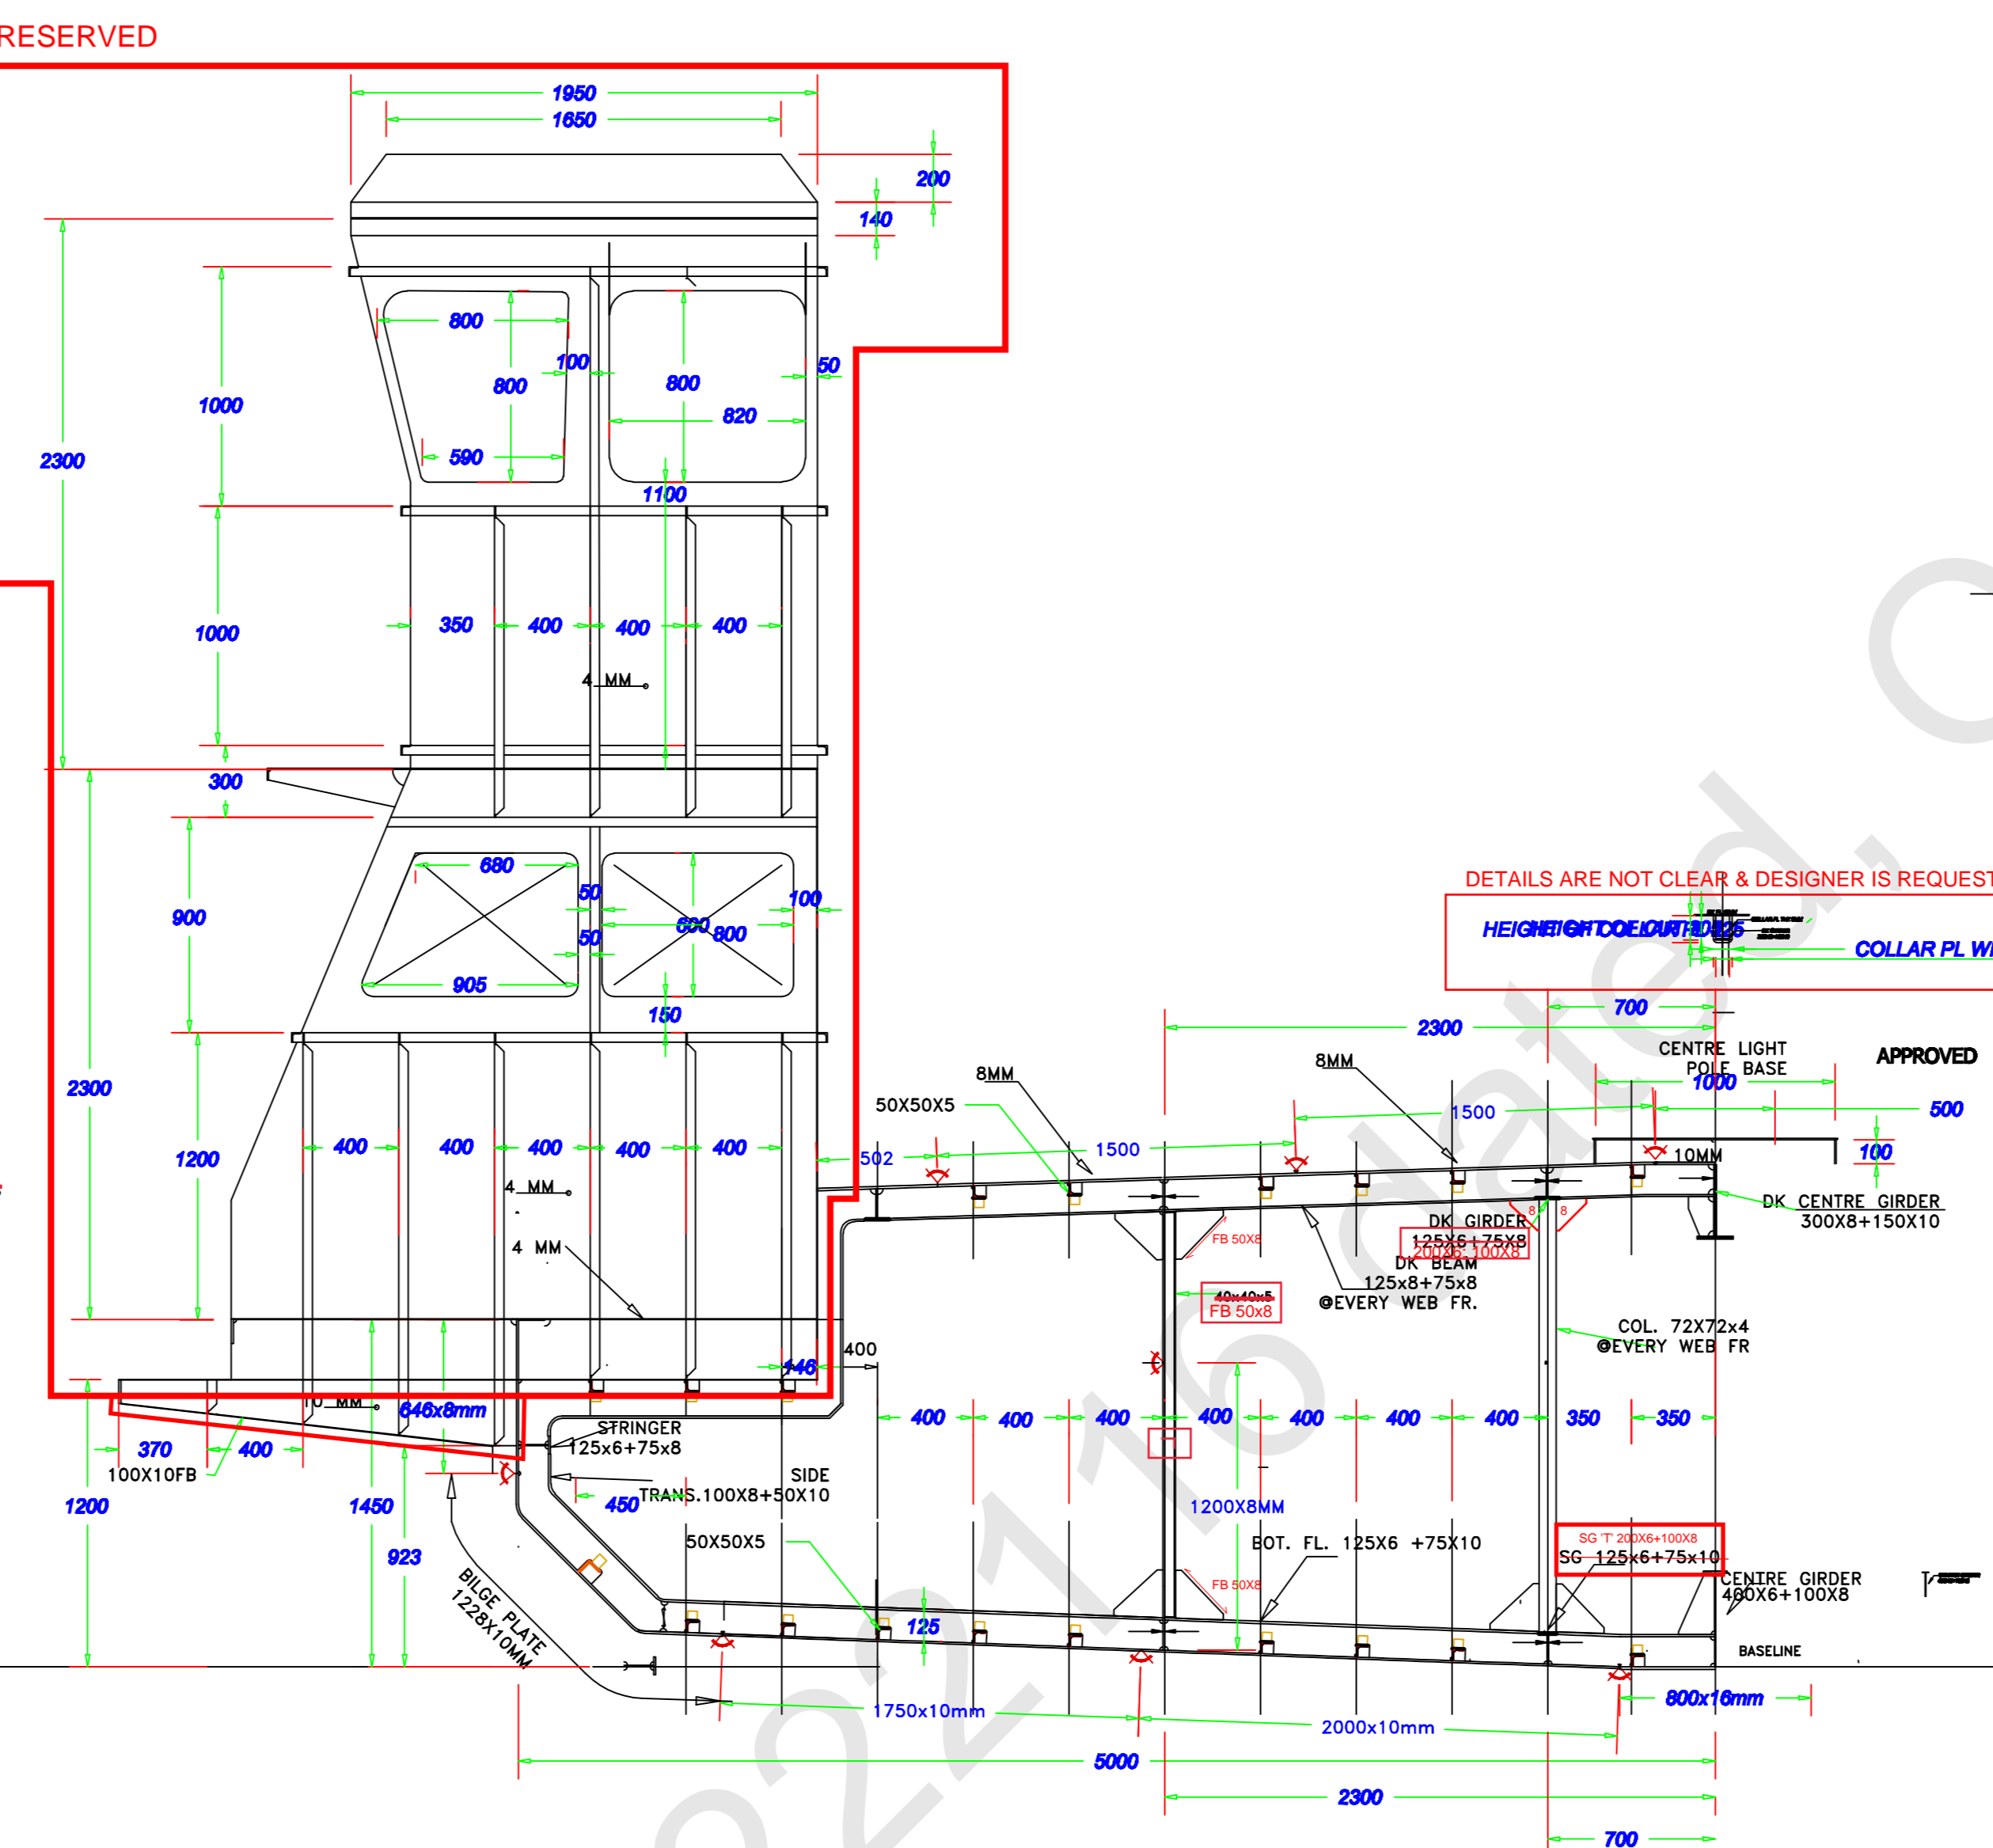


SECTION IN WAY OF FRAME 18 LOOKING FORD
(PORT SHOWN STBD SAME AS FRAME 30)
SCALE 1:25

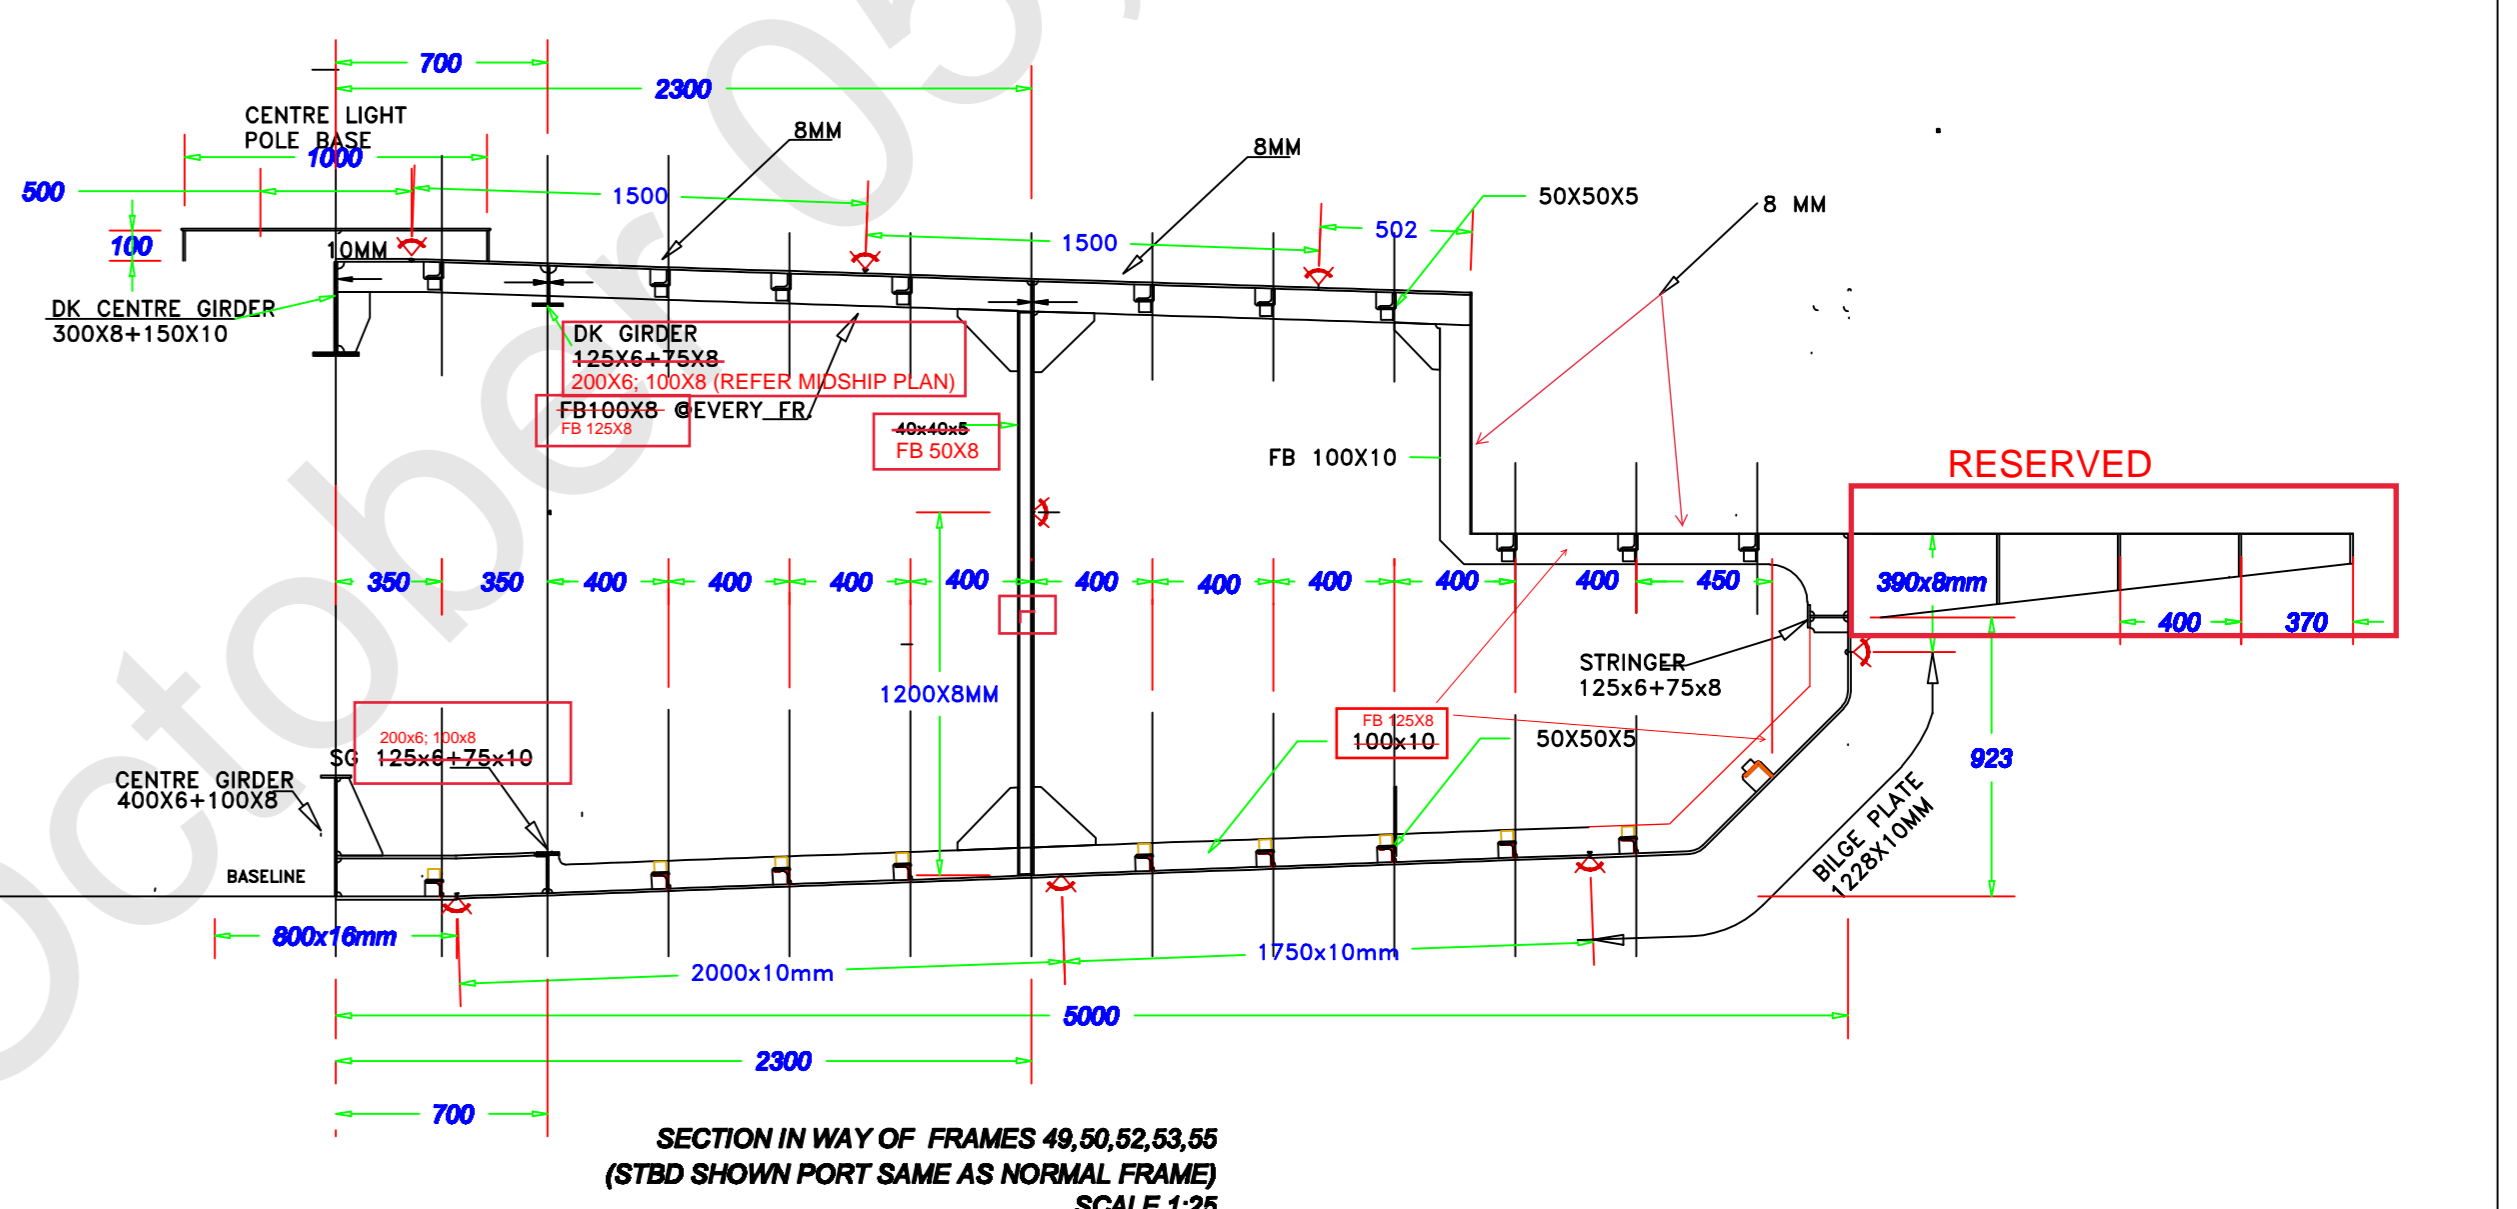


SECTION IN WAY OF FRAMES 49,50,52,53,55
(STBD SHOWN PORT SAME AS NORMAL FRAME)
SCALE 1:25

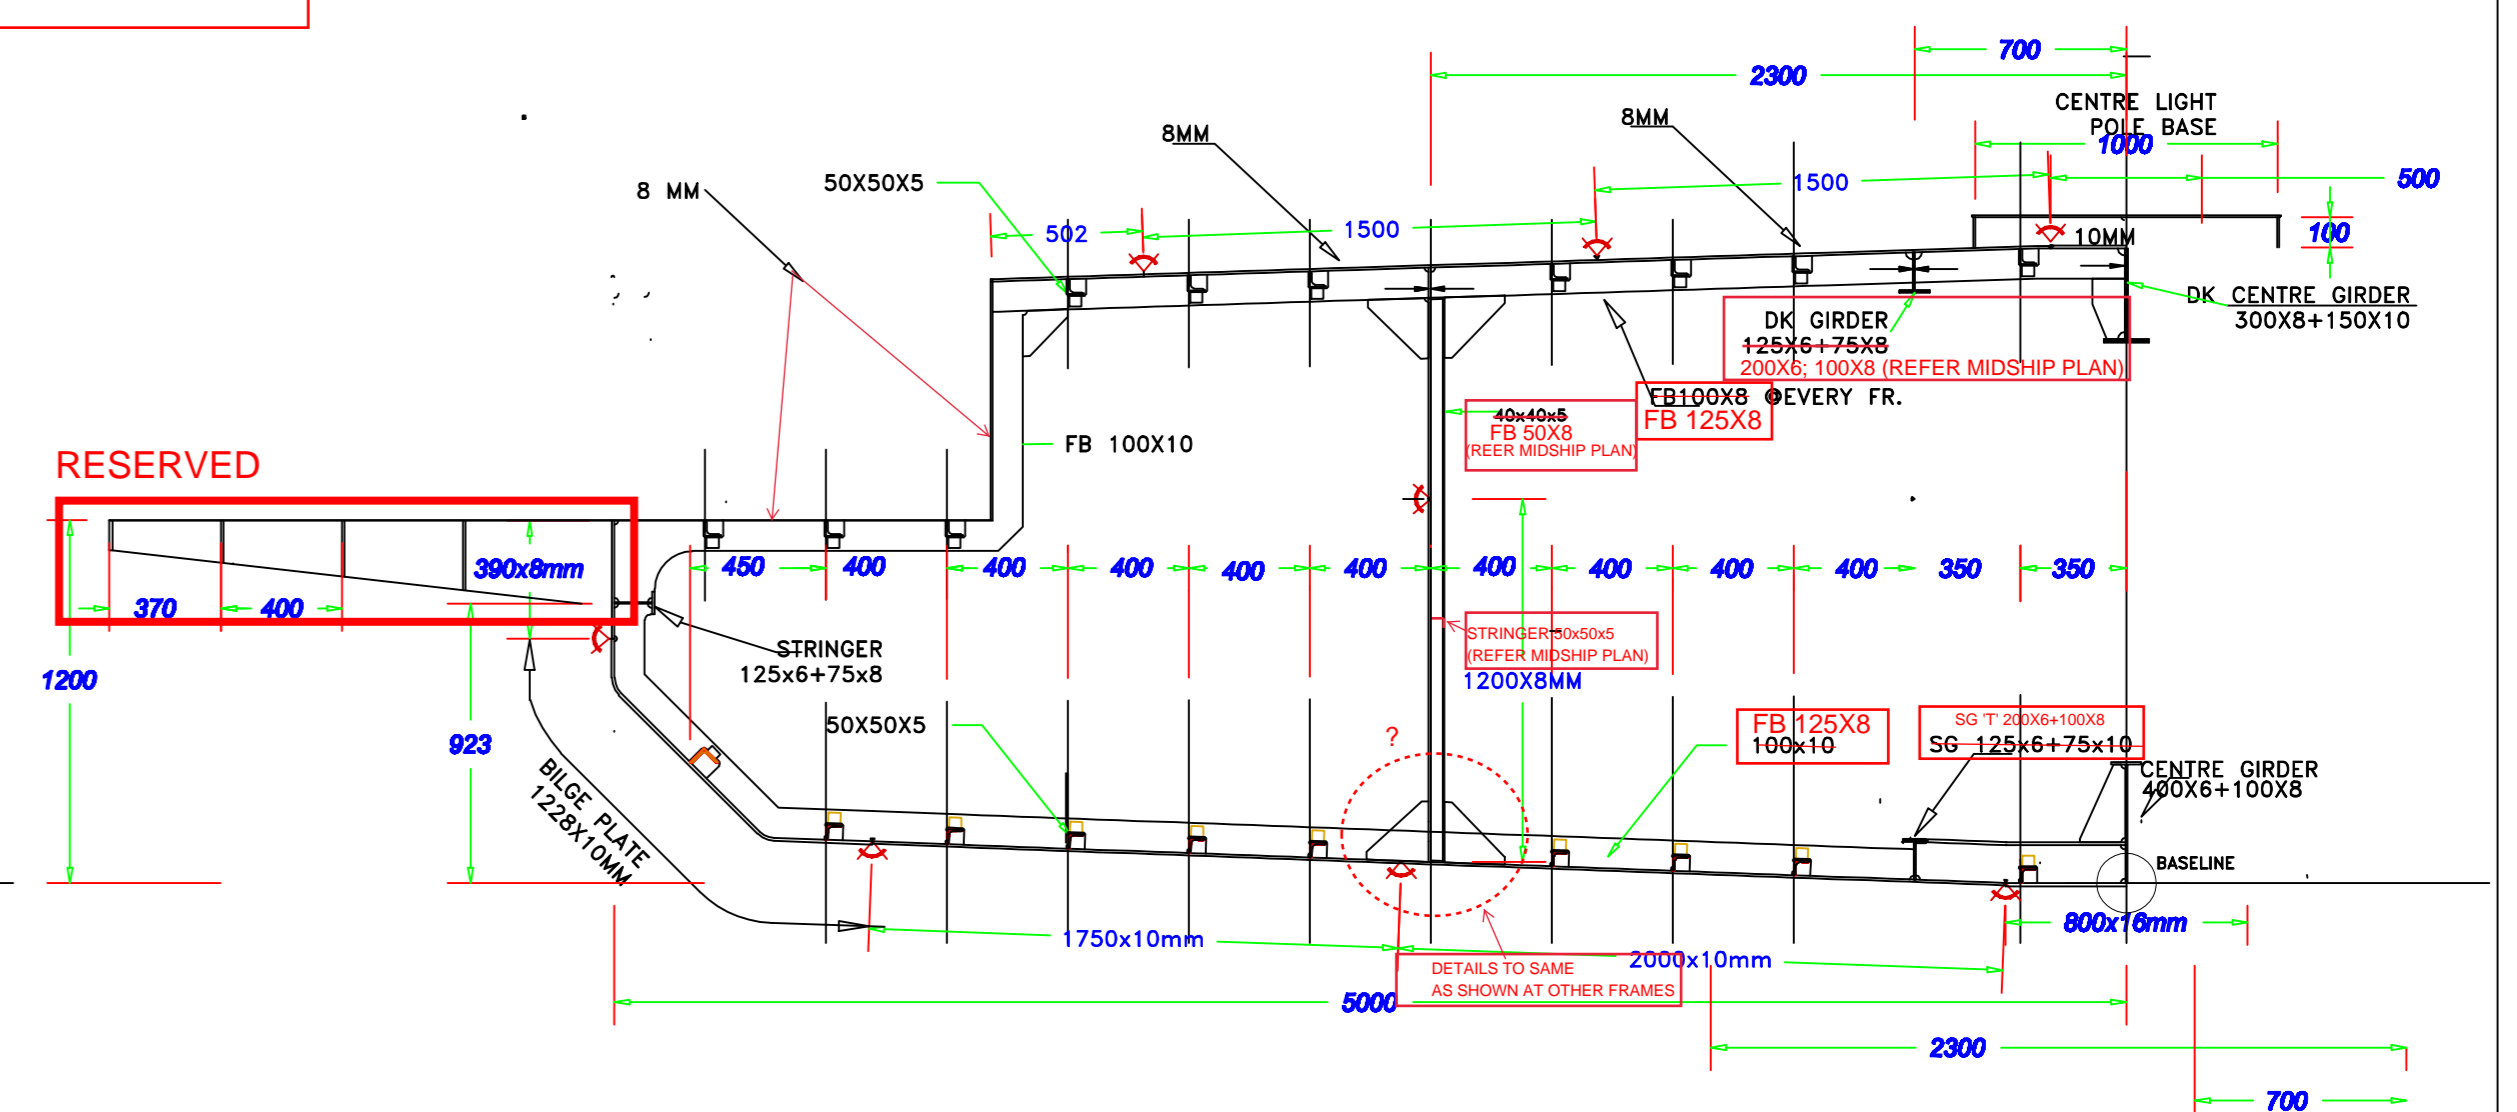


SECTION IN WAY OF FRAMES 19,20,22,23
(PORT SHOWN STBD SAME AS NORMAL FRAME)
SCALE 1:25

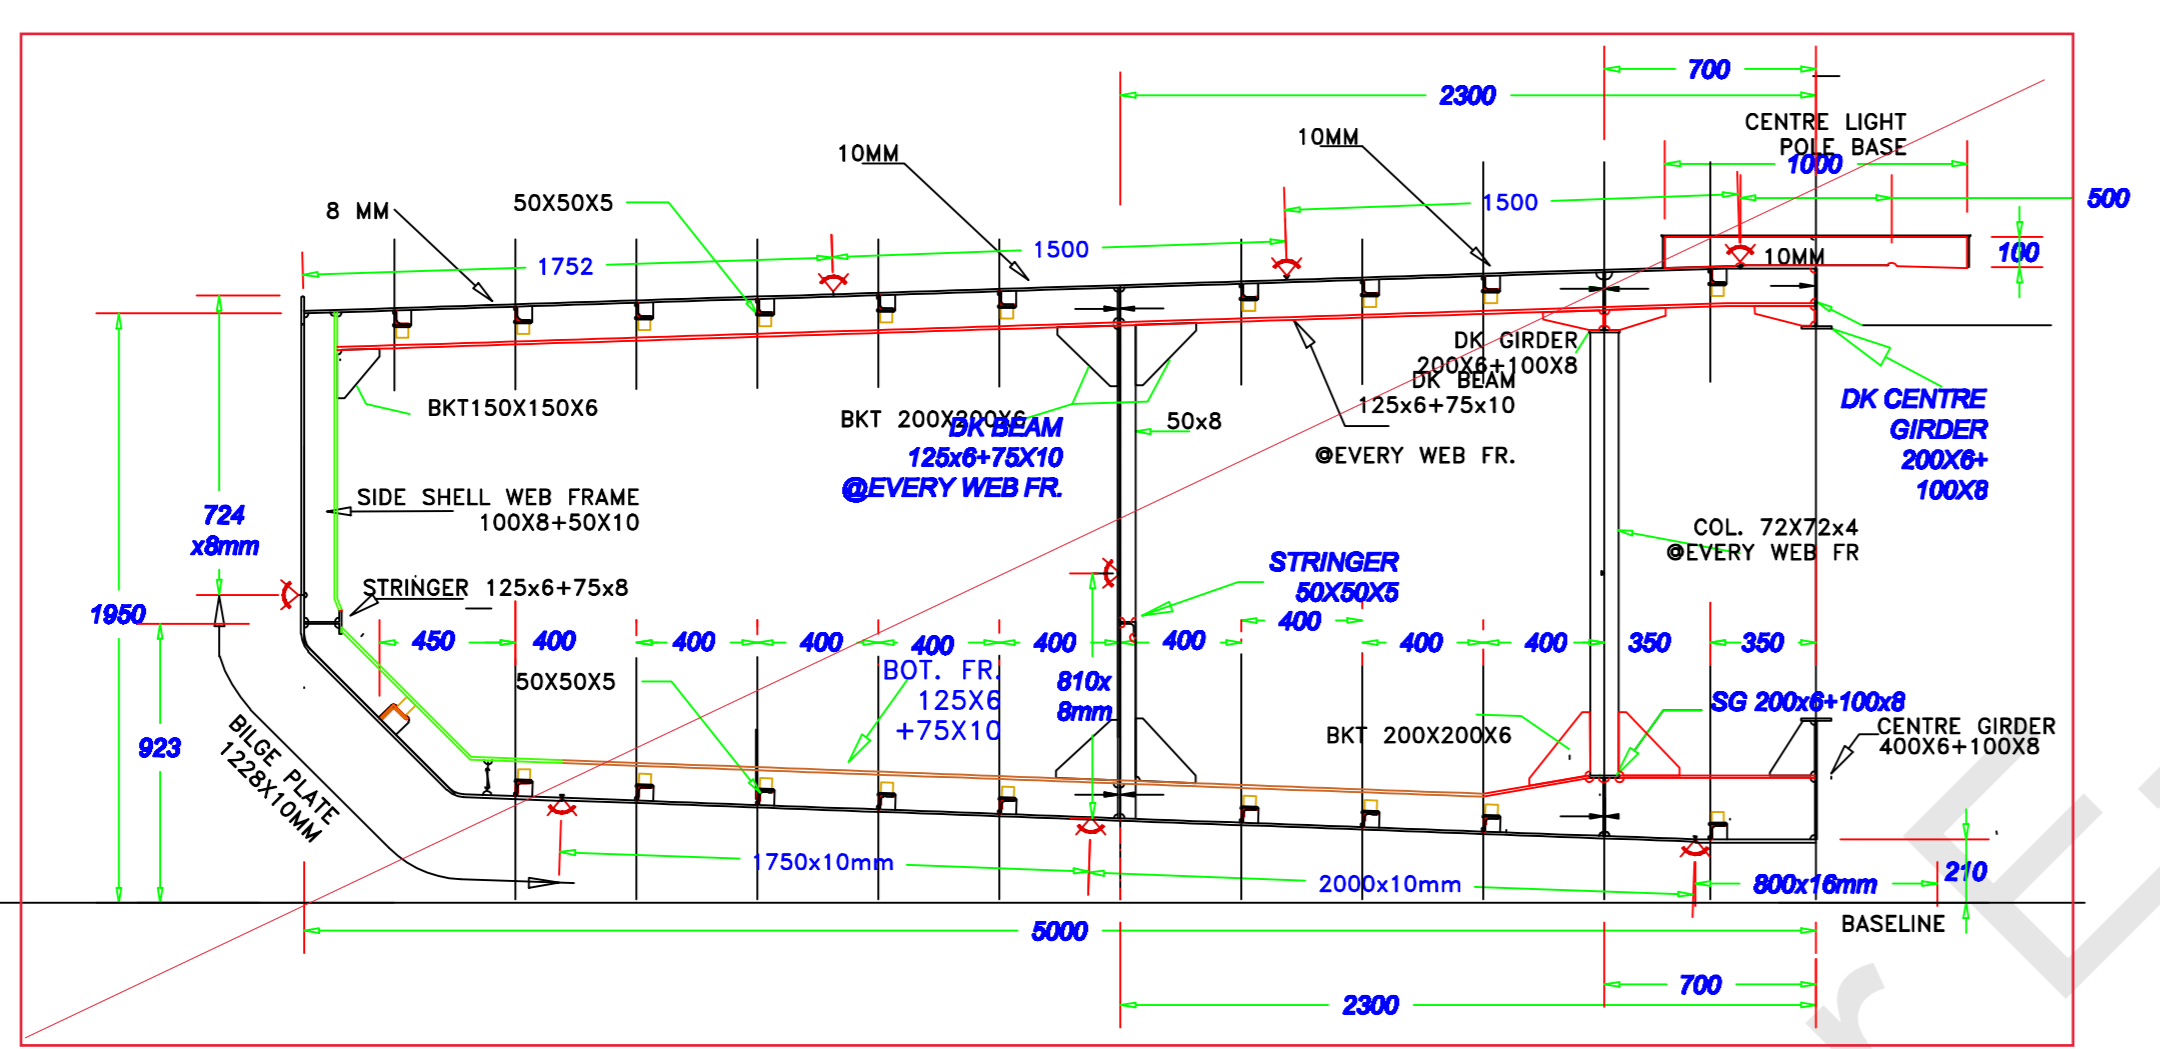

SECTION IN WAY OF FRAME 2,4
(PORT SHOWN STBD SIMILAR)
SCALE 1:25

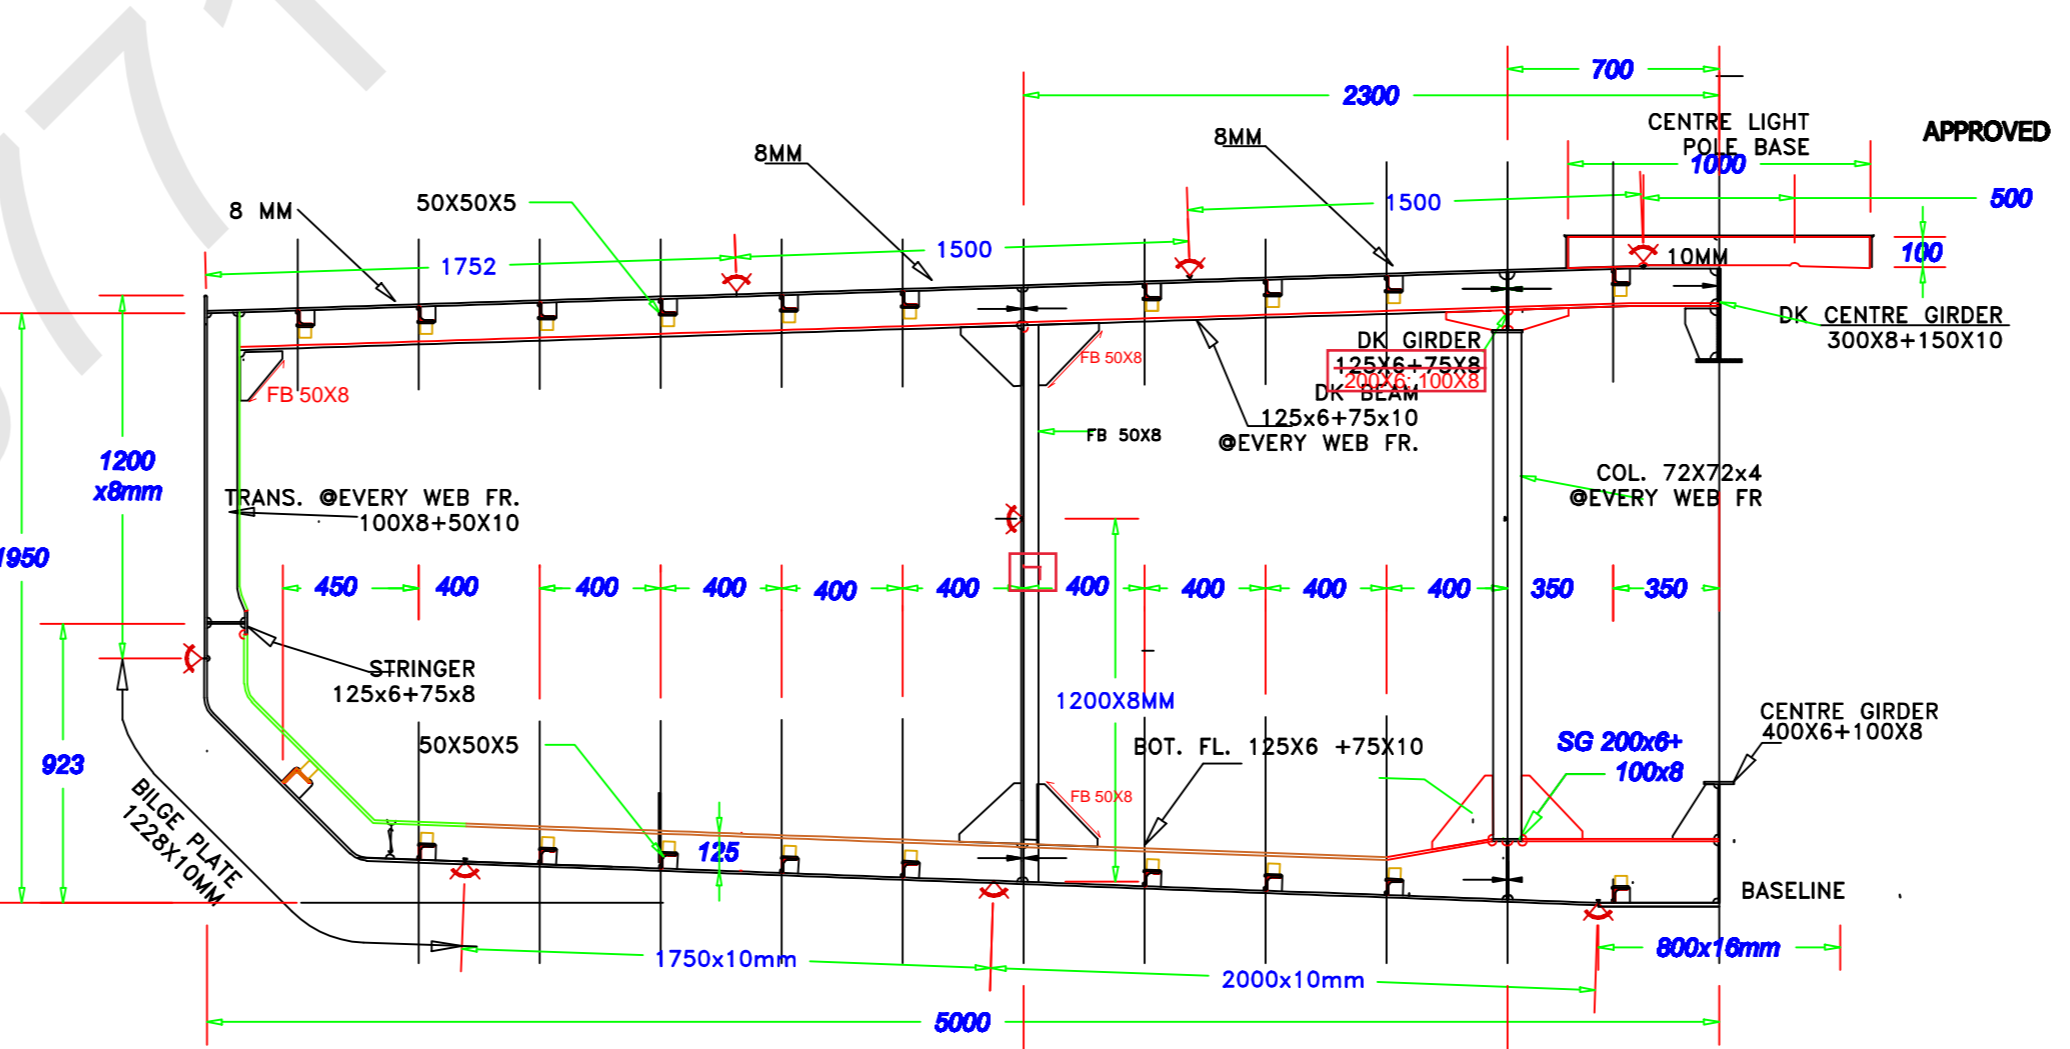


SECTION IN WAY OF WEB FRAMES 7,10,30,36,42,45,48,60
(PORT SHOWN STBD SIMILAR)
SCALE 1:25

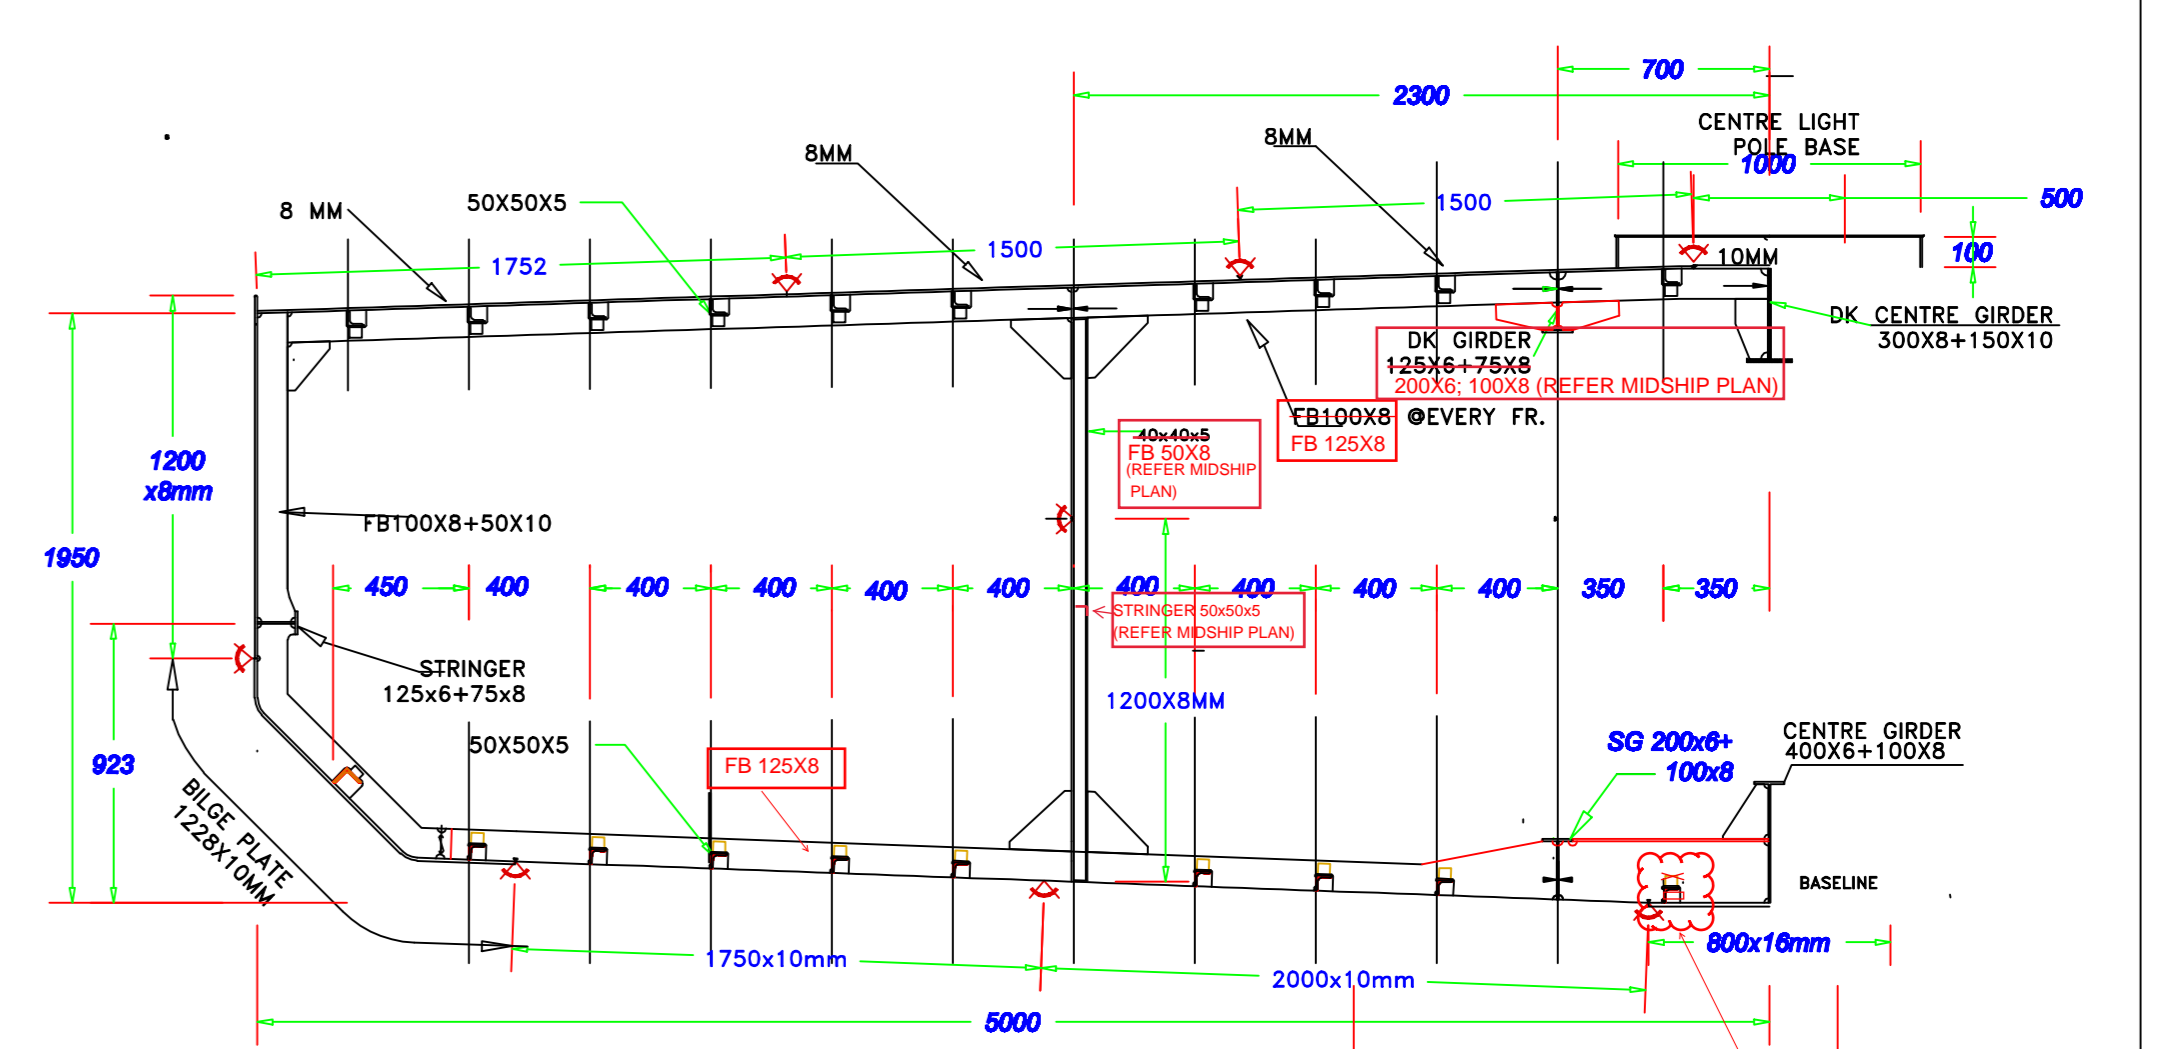

SECTION IN WAY OF TYPICAL NORMAL FRAMES
(PORT SHOWN STBD SIMILAR)
SCALE 1:25

IT IS OBSERVED THAT PLATE THICKNESS (DECK, BOTTOM, SIDE SHELL, BILGE ETC.) INDICATED IN THE PLAN ARE NOT CONSISTENT WITH APPROVED COPY OF MIDSHIP SECTION PLAN (DWG.NO : C1CMT/IAJ/KULFI/5, REV.1) ACCORDINGLY, WE HAVE CONSIDERED PLATE THICKNESS INDICATED IN MIDSHIP SECTION DURING APPROVAL OF THIS DRAWING. DESIGNER IS REQUESTED TO AMEND THE PLATE THICKNESS AS PER MIDSHIP SECTION PLAN.

SEE LETTER : E-166771-222116
INDIAN REGISTER OF SHIPPING MUMBAI AS AMENDED
DATE: 05-Oct-2022
REVIEWED
ALL MATERIAL TO BE IRS GRADE A OR EQ.

 INDIAN INSTITUTE OF TECHNOLOGY KHARAGPUR DEPARTMENT OF OCEAN ENGINEERING AND NAVAL ARCHITECTURE		QUICK MECHANICAL OPENING MECHANISM FOR PONTOON KULFI SYSTEM						
		MAIN BARGE FRAMING PLAN						
APPROVED		SIZE	SCALE	DWG. NO.	CLASS	DATE	REV. NO.	SHEETS
CHECKED		A0	1:25	C1CMT/IAJ/KULFI/7		07/MAY/2022	1	1
DRAWN								



IRCLASS
Indian Register of Shipping
CIN: U61100MH1975NPL018244

52 A, Adi Shankaracharya Marg, Opp. Powai Lake,
Powai, Mumbai - 400 072, India
Phone : +91 22 30519400 / +91 22 7119 9400
Fax : +91 22 2570 3611
E-mail : ho@irclass.org ★ Website : www.irclass.org

Our ref: E-166765-222183

12-October-2022

Company : Centre For Maritime & Coastal Maritime Technology

Dear Sir/Madam,

Your document (detailed below) has been reviewed.

Project Details	
Project number	MI001158
Project name	Design App – Main Barge (Kulfi System for IWAI)
Project Manager	Ankur Anal
Project In-Charge	Amit Waje

Document Details	
Plan No.	CICMT/IWAI/KULFI1/1
Plan Title	(1)GENERAL ARRANGEMENT PLAN Main and Moored Barge SystemMAY 07- 2022 Model
Rev.No.	2
Upload.No.	2
Submitted Date	26-September-2022
Review Status	Noted
Parent Plan Title	

Notes

1. The review status Noted indicates:
The stated plan has been noted for our information.
2. The list of remarks is part of this letter. Please address these comments by reply to us.


Thanking you,
Yours Sincerely,

For INDIAN REGISTER OF SHIPPING

Amit Gandhi
Senior Surveyor

This is an electronically published document and does not require signature.

Review Comments			
Sr.No	Comment Date	Description	Clearing Responsibility
1	12-October-2022	<p>It is noted that mooring barge is not provided with collision & aft peak bulkhead as required by IRS Inland Waterway Rule Part 3, Ch.9, Sec.2</p> <p>In view of above, calculations showing that with the ship fully loaded to summer draught on even keel, flooding of any compartment will not result in any part of the bulkhead deck / freeboard deck becoming submerged, nor result in any unacceptable loss of stability to be submitted for our review.</p>	Head Office

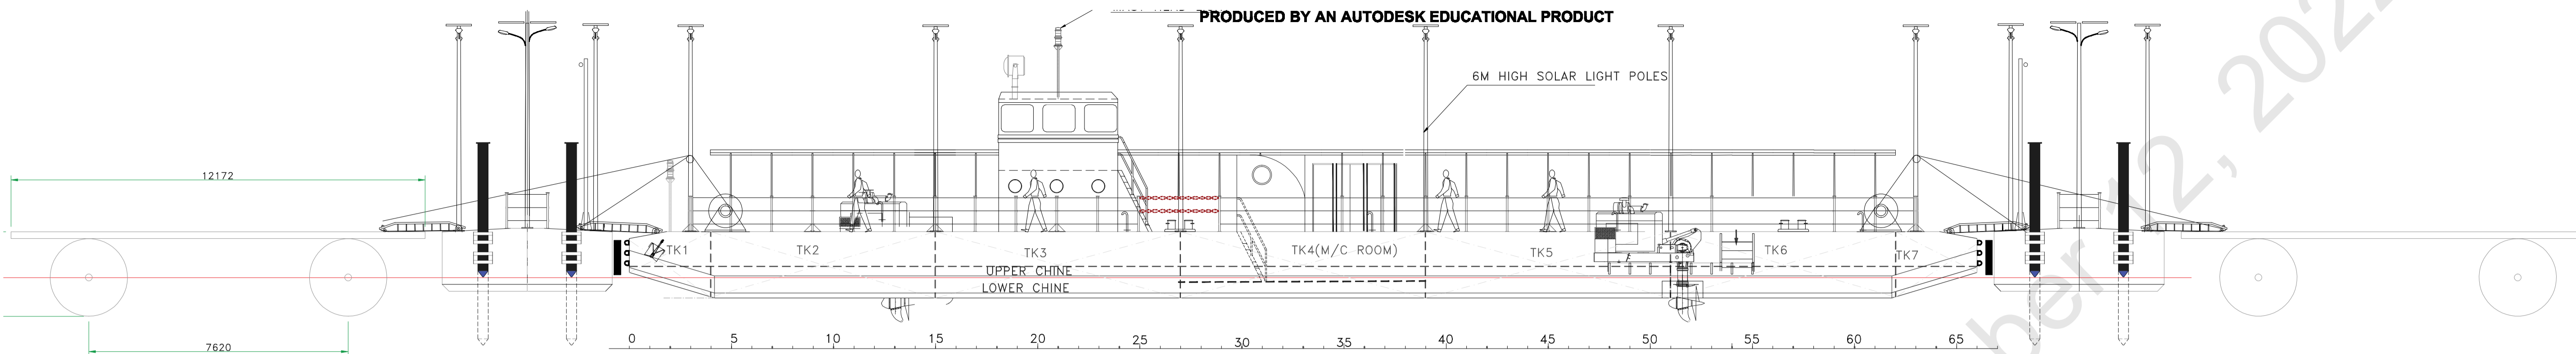


PROFILE VIEW

PRINCIPAL DIMENSIONS (MAIN BARGE)


LENGTH OVERALL	39.60 M
BREADTH OF HULL	10.00 M
BREADTH OVERALL	13.40 M
DEPTH AT SIDE	1.95 M
DEPTH AT CENTRE	2.10 M
DRAUGHT (LOADED)	0.60 M

PRINCIPAL DIMENSIONS (MOORING BARGE)


LENGTH OVERALL	20.40 M
BREADTH OF HULL	5.00 M
DEPTH AT SIDE	1.75 M
DEPTH AT CENTRE	1.85 M
DRAUGHT (LOADED)	0.40 M

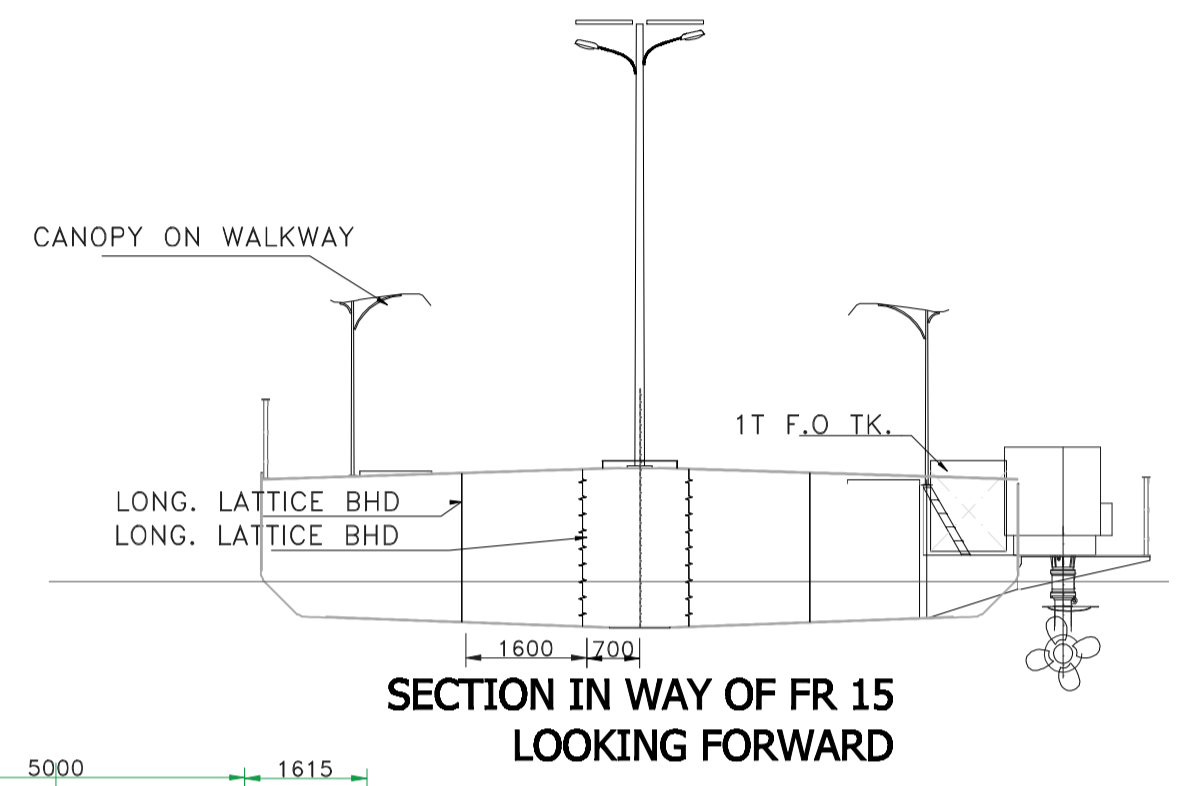


SECTION IN WAY OF FR 15
LOOKING FORWARD

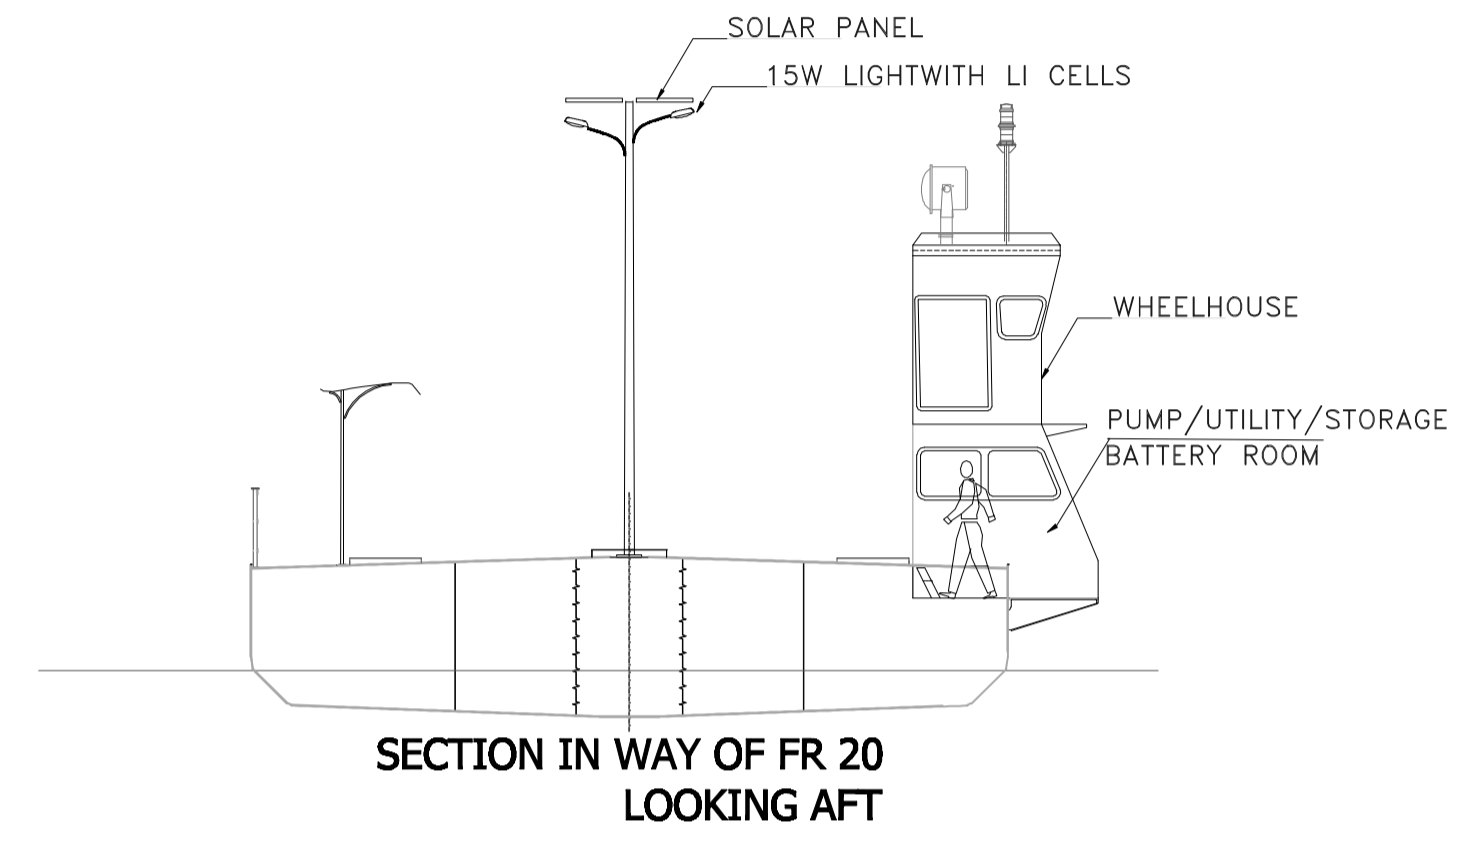

SECTION IN WAY OF FR 20
LOOKING AFT

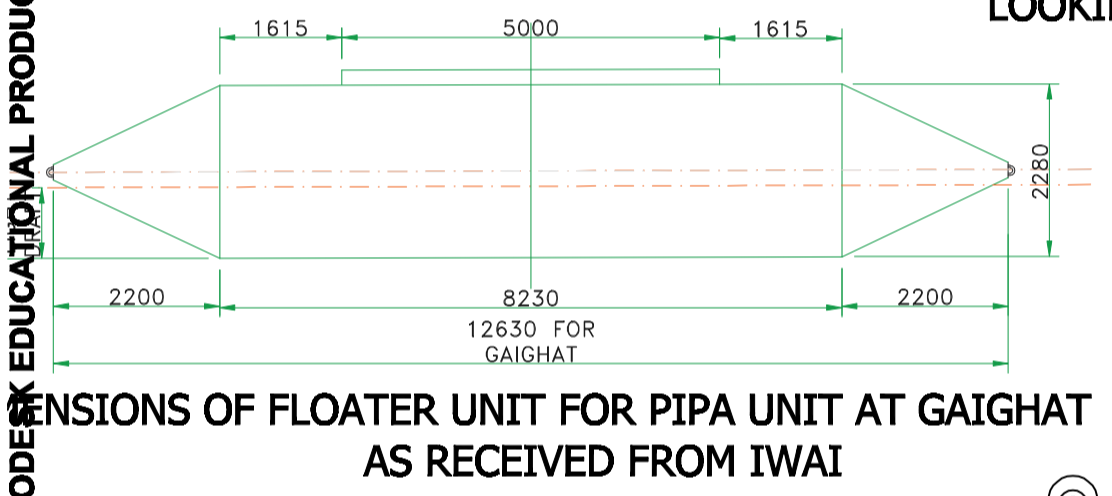


DIMENSIONS OF FLOATER UNIT FOR PIPA UNIT AT GAIGHAT
AS RECEIVED FROM IWAI

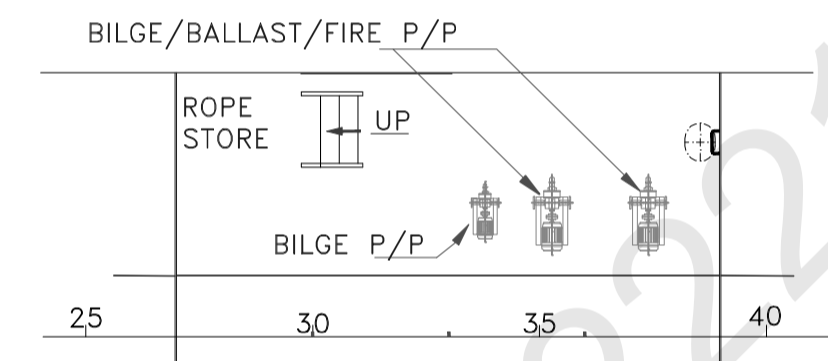


4P(M/C ROOM)
PUMP/UTILITY/STORAGE

MAIN PONTOON
IN RETRACTED
POSITION

SEE LETTER : E-166765-222183
INDIAN REGISTER OF SHIPPING
MUMBAI
DATE: 12-Oct-2022
NOTED FOR INFORMATION

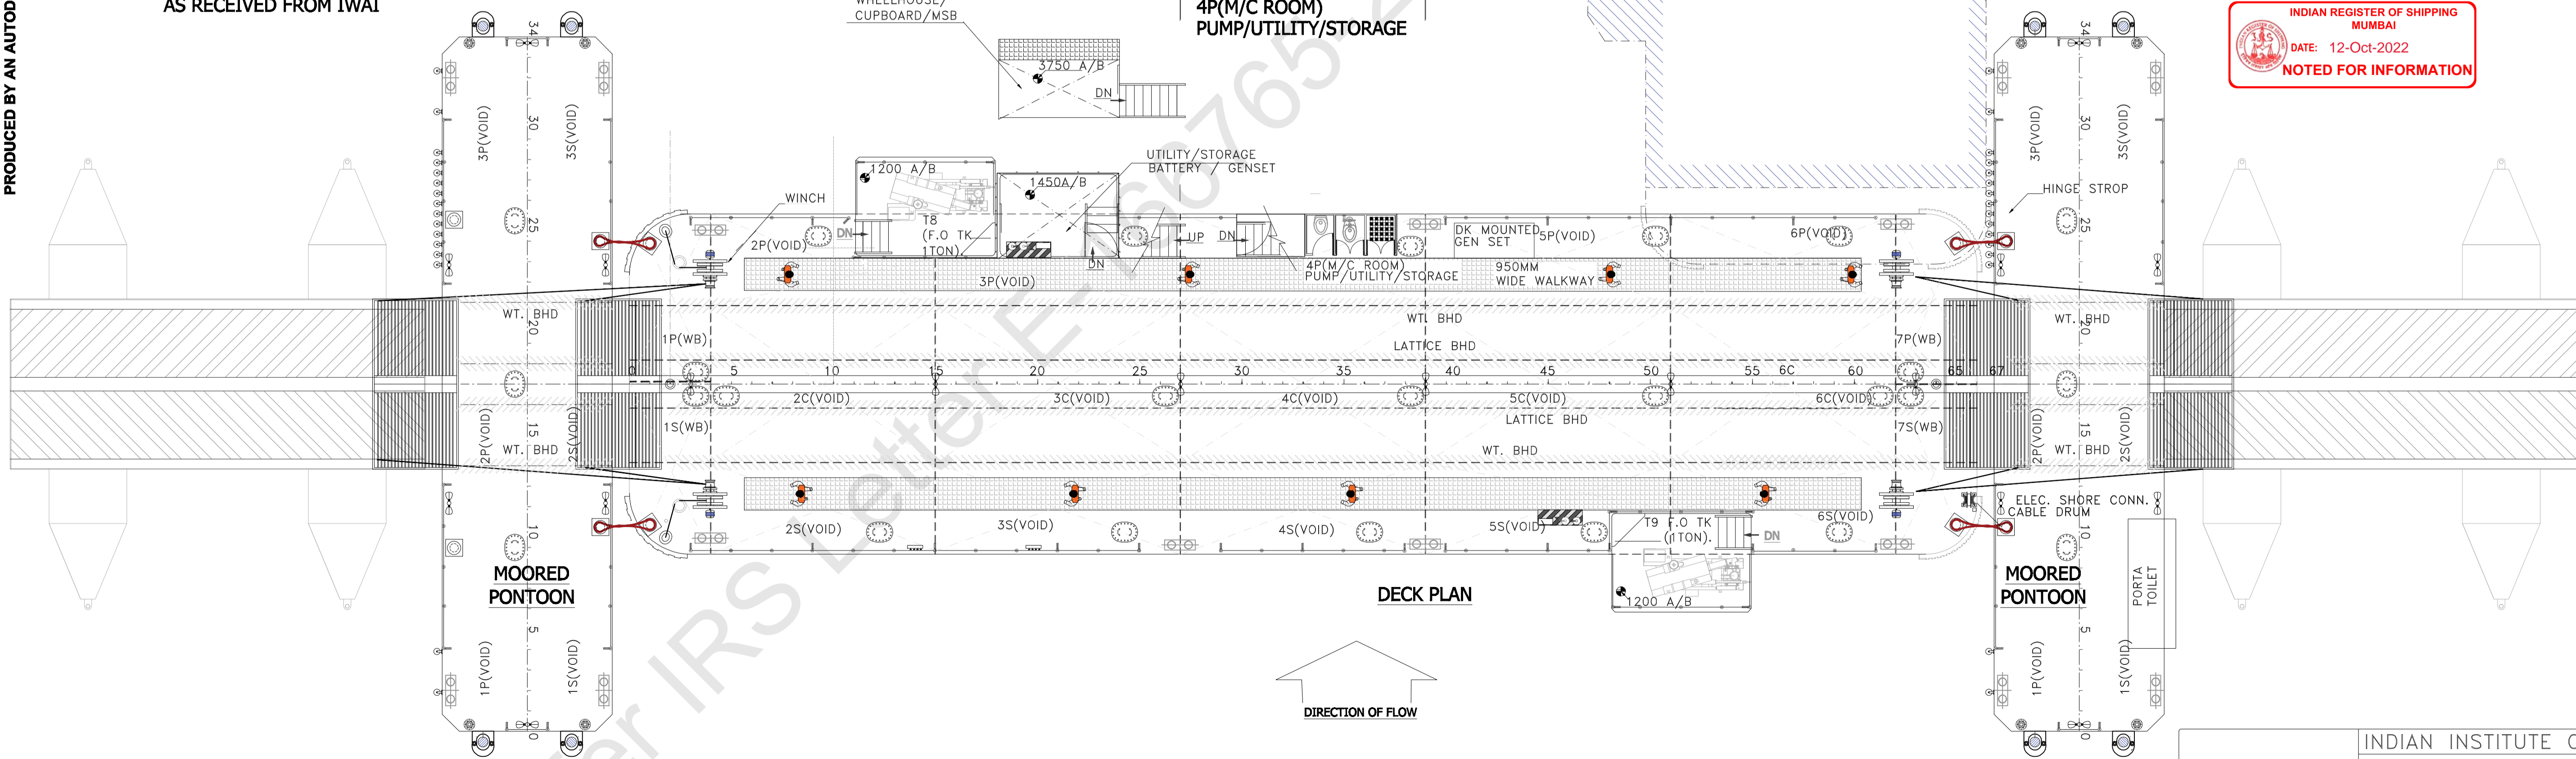

DECK PLAN

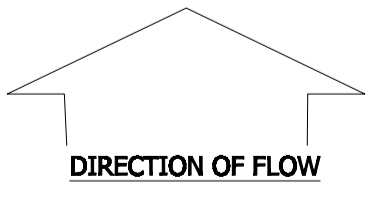

INDIAN INSTITUTE OF TECHNOLOGY KHARJ
DEPARTMENT OF OCEAN ENGINEERING AND NAVAL ARCHITECTURE(CICMT)

**QUICK MECHANICAL OPENING MECHANISM
FOR PONTOON KULFI SYSTEM**

APPROVED	
CHECKED	

GENERAL ARRANGEMENT PLAN

PRODUCED BY AN AUTODESK EDUCATIONAL PRODUCT

PRODUCED BY AN AUTODESK EDUCATIONAL PRODUCT



IRCLASS
Indian Register of Shipping
CIN: U61100MH1975NPL018244

52 A, Adi Shankaracharya Marg, Opp. Powai Lake,
Powai, Mumbai - 400 072, India
Phone : +91 22 30519400 / +91 22 7119 9400
Fax : +91 22 2570 3611
E-mail : ho@irclass.org ★ Website : www.irclass.org

Our ref: E-166768-222113

05-October-2022

Company : Centre For Maritime & Coastal Maritime Technology

Dear Sir/Madam,

Your document (detailed below) has been reviewed.

Project Details	
Project number	MI001158
Project name	Design App – Main Barge (Kulfi System for IWAI)
Project Manager	Ankur Anal
Project In-Charge	Amit Waje

Document Details	
Plan No.	CICMT/IWAI/KULFI1/4
Plan Title	MAIN BARGE DECK & PROFILE 22 MAY 2022-Model
Rev.No.	1
Upload.No.	1
Submitted Date	25-September-2022
Review Status	Reviewed
Parent Plan Title	

The plan has been examined for compliance with:

. IRS Rules

Rules and Regulations for the Construction and Classification of Inland Waterways Vessels, July 2022

Notes

1. The review status Reviewed indicates:
The stated plan has been Reviewed against appropriate Regulations/Codes/Standards.
2. The list of remarks is part of this letter. Please address these comments by reply to us.

Thanking you,
Yours Sincerely,

For INDIAN REGISTER OF SHIPPING

Amit Gandhi
Senior Surveyor

This is an electronically published document and does not require signature.

Review Comments			
Sr.No	Comment Date	Description	Clearing Responsibility
1	05-October-2022	Plans to be resubmitted for our final endorsement after finalization of shipyard.	For Info
2	05-October-2022	'\$' : (TYP.) Connection details of stanchions and diagonals to be submitted for our review.	Head Office
3	05-October-2022	Local stiffening details in way of mooring bollards/winches is not a part of our present scrutiny & these details to be seen on a separate plan.	For Info
4	05-October-2022	All amendments indicated in the plan to be duly incorporated.	For Info
5	05-October-2022	Details in way of Forepeak & Aft peak ballast tanks is reserved & these details to be seen as and when detailed transverse sectional view is submitted by designer.	Head Office



IRCLASS
Indian Register of Shipping
CIN: U61100MH1975NPL018244

52 A, Adi Shankaracharya Marg, Opp. Powai Lake,
Powai, Mumbai - 400 072, India
Phone : +91 22 30519400 / +91 22 7119 9400
Fax : +91 22 2570 3611
E-mail : ho@irclass.org ★ Website : www.irclass.org

Our ref: E-166769-222114

30-September-2022

Company : Centre For Maritime & Coastal Maritime Technology

Dear Sir/Madam,

Your document (detailed below) has been reviewed.

Project Details	
Project number	MI001158
Project name	Design App – Main Barge (Kulfi System for IWAI)
Project Manager	Ankur Anal
Project In-Charge	Amit Waje

Document Details	
Plan No.	CICMT/IWAI/KULFI1/5
Plan Title	MAIN BARGE MIDSHIP SECTION 20MAY2022-Model
Rev.No.	1
Upload.No.	1
Submitted Date	25-September-2022
Review Status	Reviewed
Parent Plan Title	

The plan has been examined for compliance with:

. IRS Rules

Rules and Regulations for the Construction and Classification of Inland Waterways Vessels, July 2022

Notes

1. The review status Reviewed indicates:
The stated plan has been Reviewed against appropriate Regulations/Codes/Standards.
2. The list of remarks is part of this letter.

Thanking you,
Yours Sincerely,

For INDIAN REGISTER OF SHIPPING

Amit Gandhi
Senior Surveyor

This is an electronically published document and does not require signature.

Review Comments			
Sr.No	Comment Date	Description	Clearing Responsibility
1	30-September-2022	Plans to be resubmitted for our final endorsement after finalization of shipyard.	For Info
2	30-September-2022	Amendments indicated in the plan to be duly incorporated.	For Info
3	30-September-2022	<p>Plan is reviewed considering following loads:</p> <ol style="list-style-type: none">1. Maximum axle load on Deck= 0.75T, Number of load area per axle =2, tyre print area = 300 mm x 150 mm2. Live load on Deck = 500 kg/m2 <p>Should there be change in above design loads, plan need to be re-examined.</p>	For Info



IRCLASS
Indian Register of Shipping
CIN: U61100MH1975NPL018244

52 A, Adi Shankaracharya Marg, Opp. Powai Lake,
Powai, Mumbai - 400 072, India
Phone : +91 22 30519400 / +91 22 7119 9400
Fax : +91 22 2570 3611
E-mail : ho@irclass.org ★ Website : www.irclass.org

Our ref: E-166770-222115

06-October-2022

Company : Centre For Maritime & Coastal Maritime Technology

Dear Sir/Madam,

Your document (detailed below) has been reviewed.

Project Details	
Project number	MI001158
Project name	Design App – Main Barge (Kulfi System for IWAI)
Project Manager	Ankur Anal
Project In-Charge	Amit Waje

Document Details	
Plan No.	CICMT/IWAI/KULFI1/6
Plan Title	MAIN BARGE TYP.BULKHEAD 07 MAY 2022-Model
Rev.No.	1
Upload.No.	1
Submitted Date	25-September-2022
Review Status	Reviewed
Parent Plan Title	

The plan has been examined for compliance with:

. IRS Rules

Rules and Regulations for the Construction and Classification of Inland Waterways Vessels, July 2022

Notes

1. The review status Reviewed indicates:
The stated plan has been Reviewed against appropriate Regulations/Codes/Standards.
2. The list of remarks is part of this letter.





Thanking you,
Yours Sincerely,

For INDIAN REGISTER OF SHIPPING

Amit Gandhi
Senior Surveyor

This is an electronically published document and does not require signature.

Review Comments			
Sr.No	Comment Date	Description	Clearing Responsibility
1	06-October-2022	Plans to be resubmitted for our final endorsement after finalization of shipyard.	For Info
2	06-October-2022	Amendments indicated in the plan to be duly incorporated.	For Info

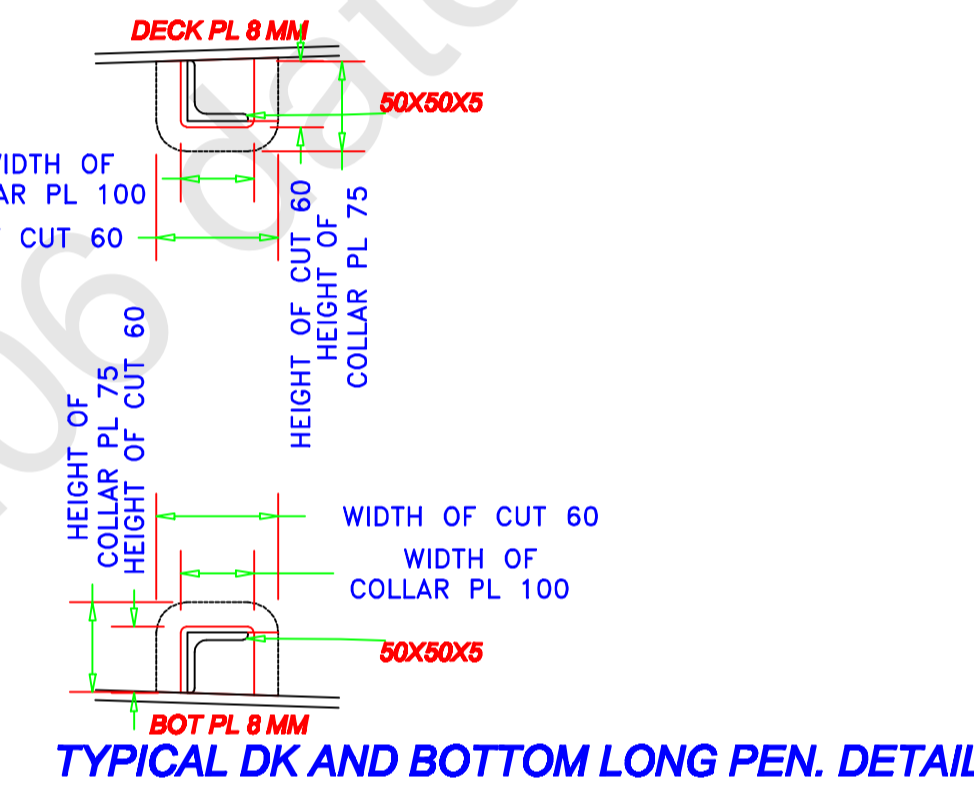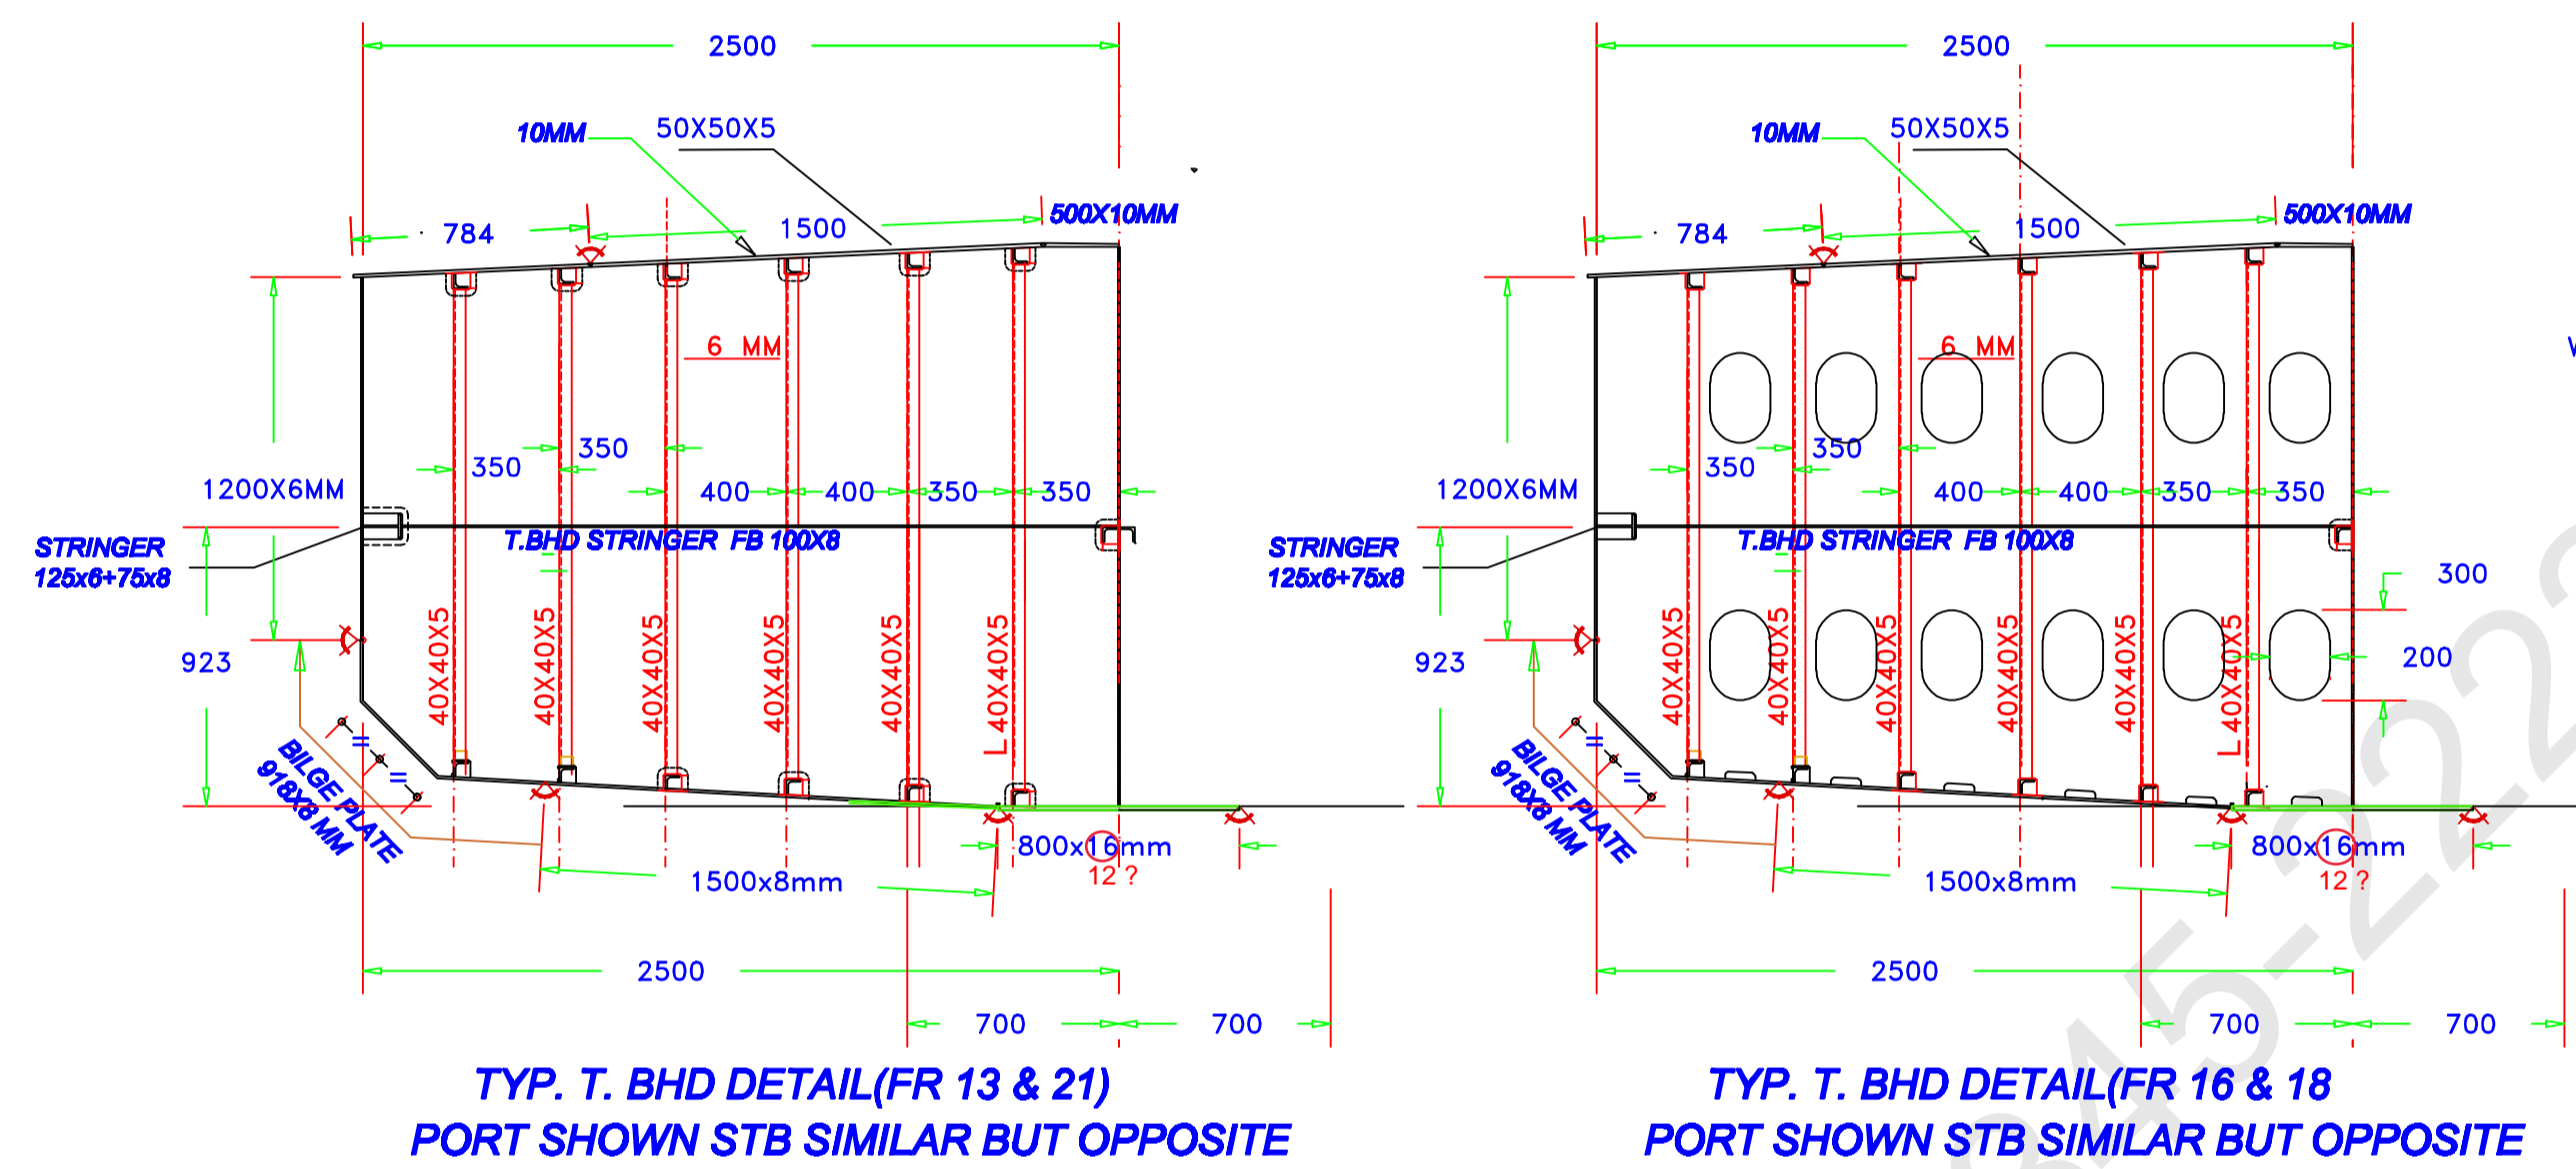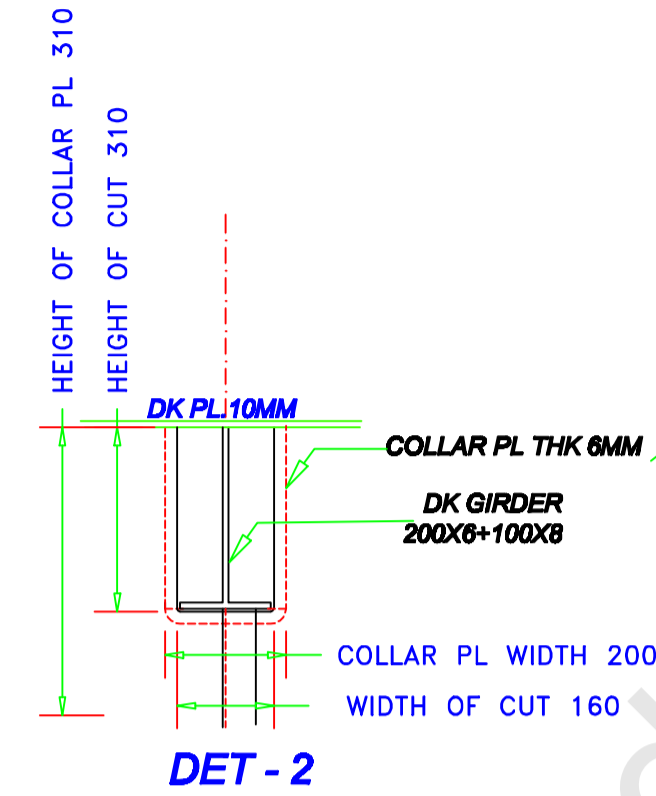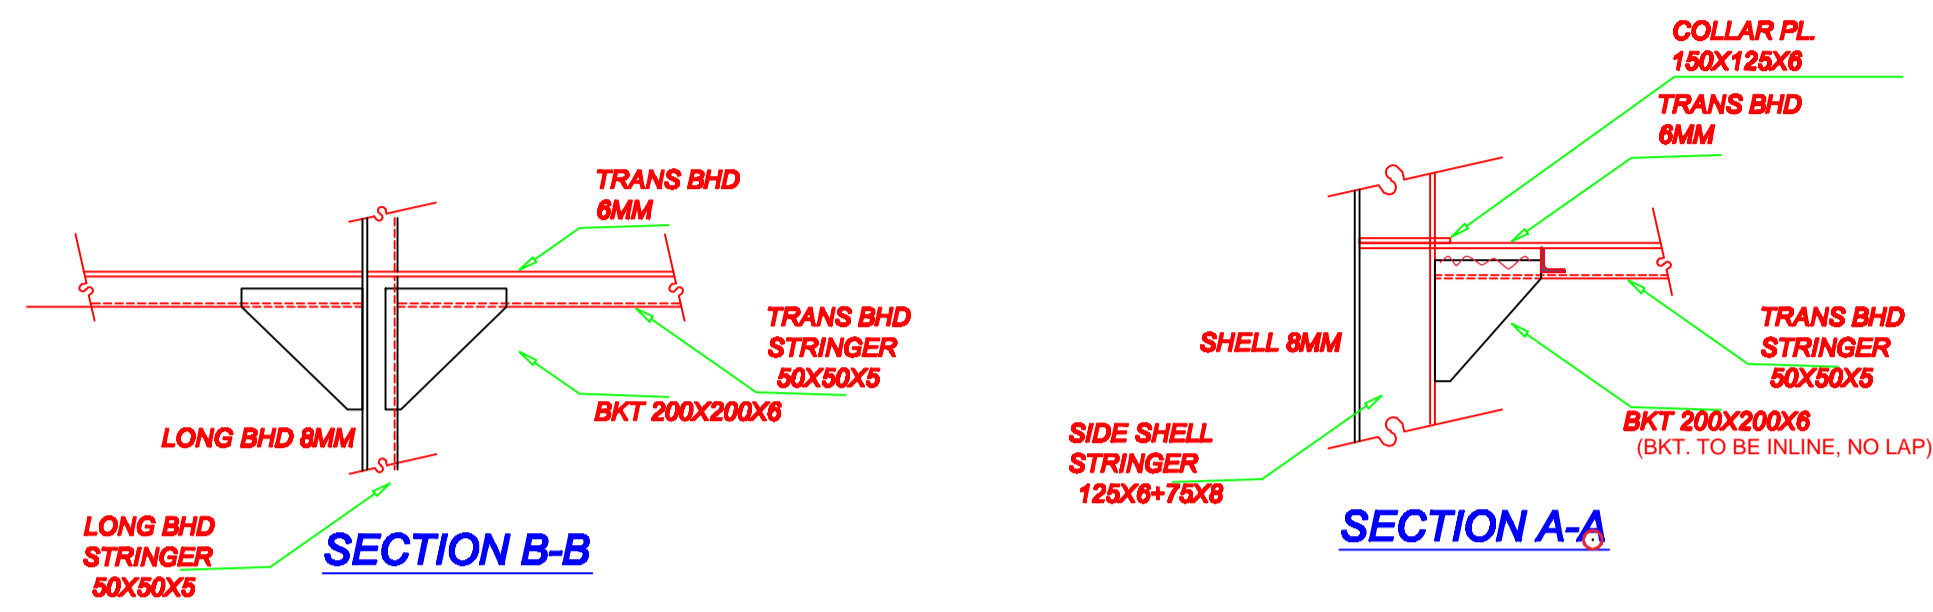


PRINCIPAL DIMENSIONS (MOORING BARGE)

LENGTH OVERALL	20.40 M
BREADTH OF HULL	05.00 M
DEPTH @ SIDE	1.75 M
DEPTH @ CENTRE	1.85 M
DRAUGHT (LOADED)	0.45 M

PLAN IS REVIEWED CONSIDERING FOLLOWING DESIGN LOADS:-

1. MAX. AXLE LOAD = 0.75T
NUMBER OF LOAD AREA PER AXLE = 2
TYRE PRINT AREA = 300X150
2. LIVE LOAD ON DECK = 500KG/M2

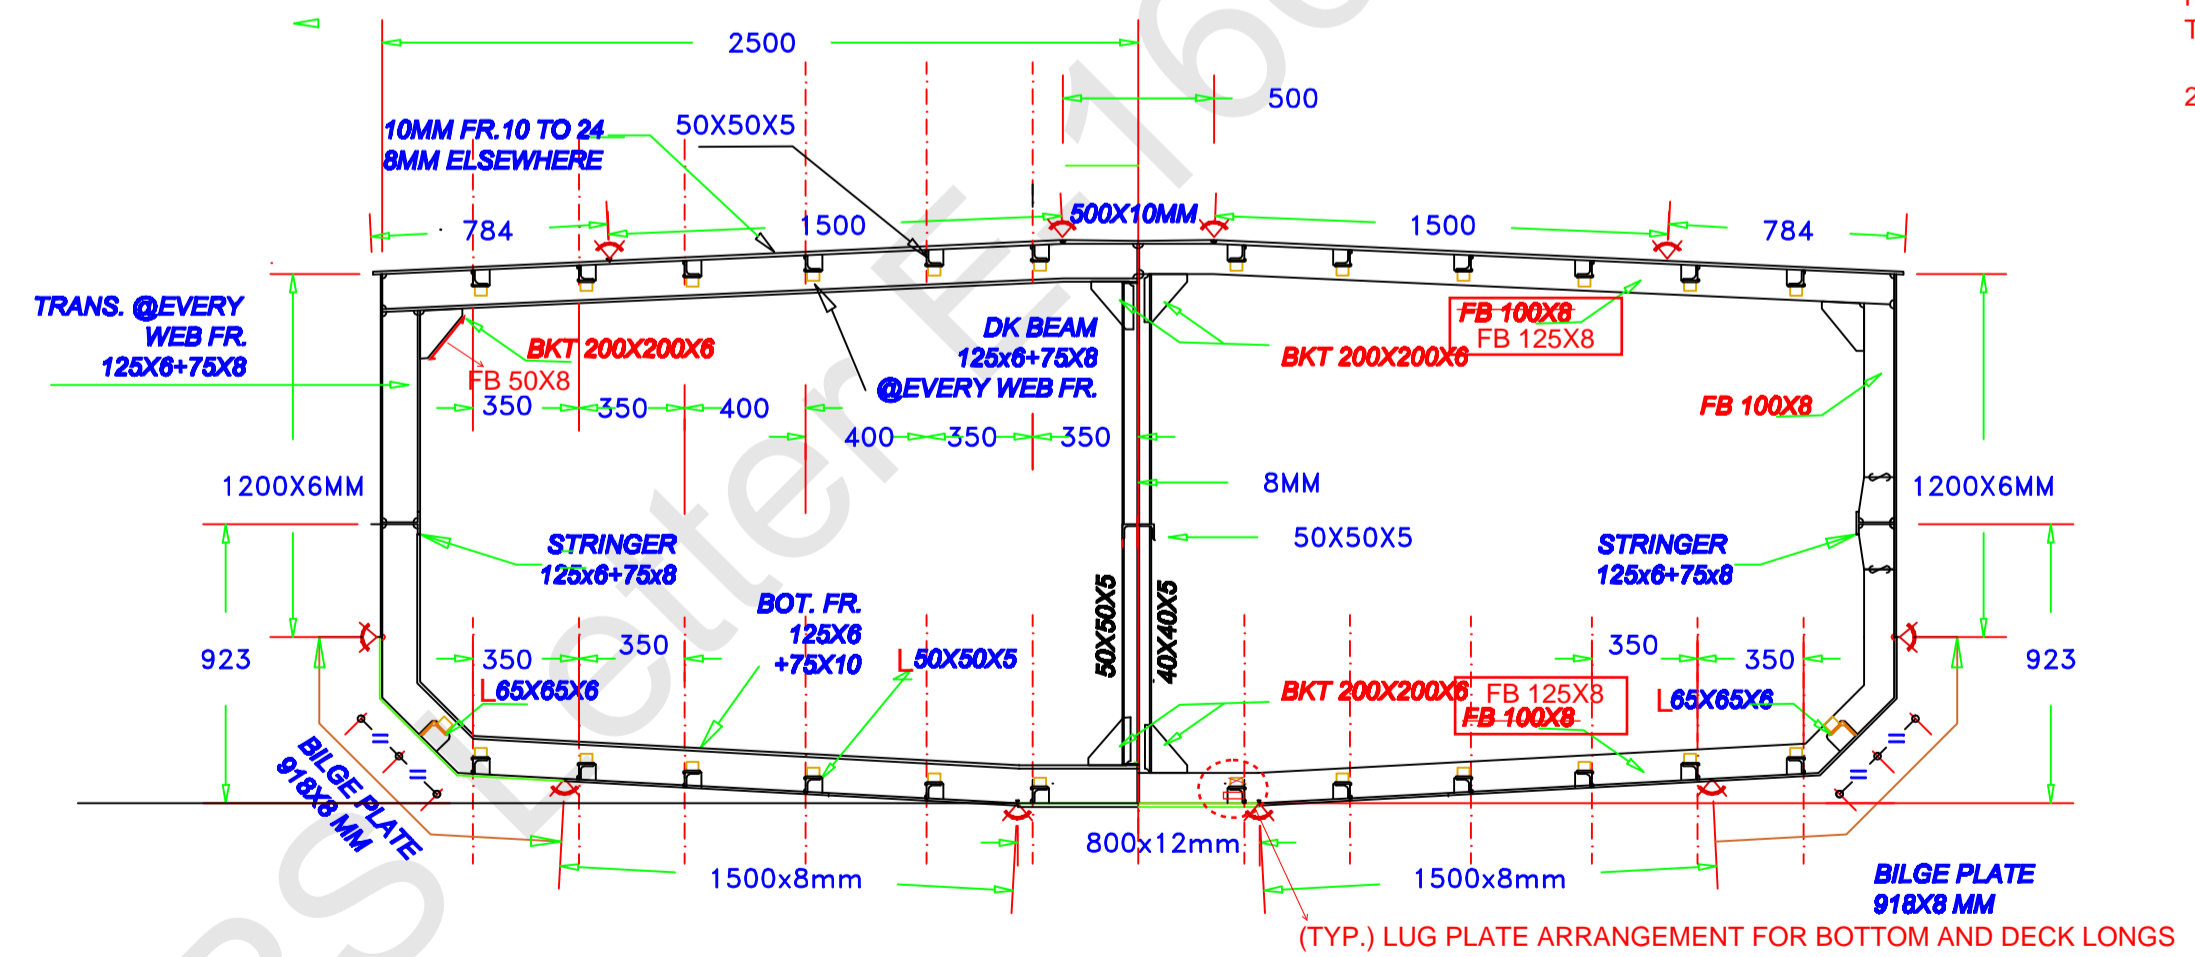

MATERIAL : ALL MATERIAL TO BE IRS GRADE A OR EQ.

SEE LETTER : E-166845-222206
 INDIAN REGISTER OF SHIPPING MUMBAI
 DATE: 13-Oct-2022
 REVIEWED AS AMENDED

CLASS NOTATION :
 SWASTIKA IW, ZONE 3, PONTOON

INDIAN INSTITUTE OF TECHNOLOGY KHARAGPUR DEPARTMENT OF OCEAN ENGINEERING AND NAVAL ARCHITECTURE (ICOMT)	
QUICK MECHANICAL OPENING MECHANISM FOR PONTOON KULFI SYSTEM	
MIDSHIP SECTION AND BULKHEAD DRAWING - MOORED BARGES	
APPROVED	
CHECKED	
DRAWN	
SIZE	A1
SCALE	1:25
DWG. NO.	CIOMT/NAVAL/PH2/05
CLASS	
DATE	07/MAY/2022
REV. NO.	1
SHEETS	1



IRCLASS
Indian Register of Shipping
CIN: U61100MH1975NPL018244

52 A, Adi Shankaracharya Marg, Opp. Powai Lake,
Powai, Mumbai - 400 072, India
Phone : +91 22 30519400 / +91 22 7119 9400
Fax : +91 22 2570 3611
E-mail : ho@irclass.org ★ Website : www.irclass.org

Our ref: E-166845-222206

13-October-2022

Company : Centre For Maritime & Coastal Maritime Technology

Dear Sir/Madam,

Your document (detailed below) has been reviewed.

Project Details	
Project number	MI001159
Project name	Design App – Mooring Barge (Kulfi System for IWAI)
Project Manager	Ankur Anal
Project In-Charge	Amit Waje

Document Details	
Plan No.	CICMT/IWAI/KULFI2/5
Plan Title	BHDS AND MIDSHIP MOORED BARGE 07 MAY 2022-Model
Rev.No.	1
Upload.No.	1
Submitted Date	26-September-2022
Review Status	Reviewed
Parent Plan Title	

The plan has been examined for compliance with:

- . IRS Rules
Rules and Regulations for the Construction and Classification of Inland Waterways Vessels, July 2022

Notes

1. The review status Reviewed indicates:
The stated plan has been Reviewed against appropriate Regulations/Codes/Standards.
2. The list of remarks is part of this letter.

Thanking you,
Yours Sincerely,

For INDIAN REGISTER OF SHIPPING

Amit Gandhi
Senior Surveyor

This is an electronically published document and does not require signature.

Review Comments			
Sr.No	Comment Date	Description	Clearing Responsibility
1	13-October-2022	Plan is reviewed considering following loads: 1. Maximum axle load on Deck= 0.75T, Number of load area per axle =2, tyre print area = 300 mm x 150 mm 2. Live load on Deck = 500 kg/m2 Should there be change in above design loads, plan need to be re-examined.	For Info
2	13-October-2022	Amendments indicated in the plan to be duly incorporated.	For Info
3	13-October-2022	Plans to be resubmitted for our final endorsement after finalization of shipyard.	For Info



IRCLASS
Indian Register of Shipping
CIN: U61100MH1975NPL018244

52 A, Adi Shankaracharya Marg, Opp. Powai Lake,
Powai, Mumbai - 400 072, India
Phone : +91 22 30519400 / +91 22 7119 9400
Fax : +91 22 2570 3611
E-mail : ho@irclass.org ★ Website : www.irclass.org

Our ref: E-166849-222210

13-October-2022

Company : Centre For Maritime & Coastal Maritime Technology

Dear Sir/Madam,

Your document (detailed below) has been reviewed.

Project Details	
Project number	MI001159
Project name	Design App – Mooring Barge (Kulfi System for IWAI)
Project Manager	Ankur Anal
Project In-Charge	Amit Waje

Document Details	
Plan No.	CICMT/IWAI/KULFI2/4
Plan Title	DECKS AND PROFILES MOORED BARGE 07 MAY 2022-Model
Rev.No.	1
Upload.No.	1
Submitted Date	26-September-2022
Review Status	Reviewed
Parent Plan Title	

The plan has been examined for compliance with:

. IRS Rules

Rules and Regulations for the Construction and Classification of Inland Waterways Vessels, July 2022

Notes

1. The review status Reviewed indicates:
The stated plan has been Reviewed against appropriate Regulations/Codes/Standards.
2. The list of remarks is part of this letter. Please address these comments by reply to us.

Thanking you,
Yours Sincerely,

For INDIAN REGISTER OF SHIPPING

Amit Gandhi
Senior Surveyor

This is an electronically published document and does not require signature.

Review Comments			
Sr.No	Comment Date	Description	Clearing Responsibility
1	13-October-2022	All amendments indicated in the plan to be duly incorporated.	For Info
2	13-October-2022	Plans to be resubmitted for our final endorsement after finalization of shipyard.	For Info
3	13-October-2022	Plan is reviewed considering following loads: 1. Maximum axle load on Deck= 0.75T, Number of load area per axle =2, tyre print area = 300 mm x 150 mm 2. Live load on Deck = 500 kg/m2 Should there be change in above design loads, plan need to be re-examined.	For Info
4	13-October-2022	Strengthening details in way of Pile guide is reserved & these details to be seen on separate plan as and when submitted by designer.	Head Office



IRCLASS
Indian Register of Shipping
CIN: U61100MH1975NPL018244

52 A, Adi Shankaracharya Marg, Opp. Powai Lake,
Powai, Mumbai - 400 072, India
Phone : +91 22 30519400 / +91 22 7119 9400
Fax : +91 22 2570 3611
E-mail : ho@irclass.org ★ Website : www.irclass.org

Our ref: E-166841-222202

12-October-2022

Company : Centre For Maritime & Coastal Maritime Technology

Dear Sir/Madam,

Your document (detailed below) has been reviewed.

Project Details	
Project number	MI001159
Project name	Design App – Mooring Barge (Kulfi System for IWAI)
Project Manager	Ankur Anal
Project In-Charge	Amit Waje

Document Details	
Plan No.	CICMT/IWAI/KULFI1/1
Plan Title	GENERAL ARRANGEMENT FERRY-CUM-PONTOON SYSTEM 26SEP2022 REV2-Model
Rev.No.	2
Upload.No.	1
Submitted Date	26-September-2022
Review Status	Noted
Parent Plan Title	

Notes

1. The review status Noted indicates:
The stated plan has been noted for our information.
2. The list of remarks is part of this letter. Please address these comments by reply to us.

Thanking you,
Yours Sincerely,

For INDIAN REGISTER OF SHIPPING

Amit Gandhi
Senior Surveyor

This is an electronically published document and does not require signature.

Review Comments			
Sr.No	Comment Date	Description	Clearing Responsibility
1	12-October-2022	<p>It is noted that mooring barge is not provided with collision & aft peak bulkhead as required by IRS Inland Waterway Rule Part 3, Ch.9, Sec.2</p> <p>In view of above, calculations showing that with the ship fully loaded to summer draught on even keel, flooding of any compartment will not result in any part of the bulkhead deck /freeboard deck becoming submerged, nor result in any unacceptable loss of stability to be submitted for our review.</p>	Head Office



IRCLASS
Indian Register of Shipping
CIN: U61100MH1975NPL018244

52 A, Adi Shankaracharya Marg, Opp. Powai Lake,
Powai, Mumbai - 400 072, India
Phone : +91 22 30519400 / +91 22 7119 9400
Fax : +91 22 2570 3611
E-mail : ho@irclass.org ★ Website : www.irclass.org

Our ref: E-166854-222215

08-December-2022

Company : Centre For Maritime & Coastal Maritime Technology

Dear Sir/Madam,

Your document (detailed below) has been reviewed.

Project Details	
Project number	MI001159
Project name	Design App – Mooring Barge (Kulfi System for IWAI)
Project Manager	Ankur Anal
Project In-Charge	Amit Waje

Document Details	
Plan No.	CICMT/IWAI/KULFI2/7
Plan Title	MooredBarge-Hydro-KN-GZ-tankcalib
Rev.No.	1
Upload.No.	1
Submitted Date	26-September-2022
Review Status	Reviewed
Parent Plan Title	

Notes

1. The review status Reviewed indicates:

Preliminary Stability Booklet has been examined pursuant to the requirements of 2008 Intact Stability Code, Part B, Chapter 2.2 and found to be in order based on the following conditions:

- The Loading conditions have been verified based on the estimated lightship particulars.
- Loading conditions 1& 2 is verified for Inland unmanned tow in fair weather and against favourable weather forecast only (Significant wave height not exceeding 0.6 m).

Stability booklet to be resubmitted for our final endorsement after finalization of shipyard.

2. The list of remarks is part of this letter.

Thanking you,
Yours Sincerely,

For INDIAN REGISTER OF SHIPPING

Ramiz Ismail
Sr. Surveyor

This is an electronically published document and does not require signature.

Review Comments			
Sr.No	Comment Date	Description	Clearing Responsibility
1	08-December-2022	The following details are to be included in the stability booklet. <ul style="list-style-type: none">• General Particulars• Coordinate reference, sign conventions• Notes on stability• Stability criteria followed have to be described• Details of unprotected openings (if any)• Draft mark plan• General arrangement plan.	For Info

REV. NO.	DATE	DESCRIPTION	BY	CHK.	APP.
0	7 ^H MAY-2022	Moored barge: Hydrostatics, KN-curves, Tank-calibration, Intact Stability			

**DESIGN OF
QUICK MECHANICAL OPENING MECHANISM
FOR
PONTOON KULFI SYSTEM**

SEE LETTER: E-166854-222215

AS AMENDED
SEE PAGE NO. 11-15



HULL NO.	PROJECT			
	PONTOON KULFI SYSTEM			
APPROVED		Moored barge: Hydrostatics, KN-curves, Tank-calibration, Intact Stability		
CHECKED				
PREPARED				
	DATE	DRAWING NO.	REV. NO.	SHEETS
	02-MAY-2022	CICMT/IWAI/KULFI2/7	1	


APPENDIX 2

Hydrostatics - patna-moored barge_R4 Intact

Fixed Trim = 0 m (+ve by stern)

Specific gravity = 1.025; (Density = 1.025 tonne/m³)

Draft Amidships m	0.150	0.250	0.350	0.450	0.550	0.650	0.750	0.850	0.950	1.050	1.150	1.250	1.350	1.450	1.550	1.650	1.750
Displacement t	10.29	20.11	30.34	40.79	51.23	61.68	72.12	82.56	93.01	103.5	113.9	124.3	134.8	145.2	155.7	166.1	176.6
Heel deg	0.0	0.0	0.0	0.0	0.0	0.0	0.0	0.0	0.0	0.0	0.0	0.0	0.0	0.0	0.0	0.0	0.0
Draft at FP m	0.150	0.250	0.350	0.450	0.550	0.650	0.750	0.850	0.950	1.050	1.150	1.250	1.350	1.450	1.550	1.650	1.750
Draft at AP m	0.150	0.250	0.350	0.450	0.550	0.650	0.750	0.850	0.950	1.050	1.150	1.250	1.350	1.450	1.550	1.650	1.750
Draft at LCF m	0.150	0.250	0.350	0.450	0.550	0.650	0.750	0.850	0.950	1.050	1.150	1.250	1.350	1.450	1.550	1.650	1.750
Trim (+ve by stern) m	0.000	0.000	0.000	0.000	0.000	0.000	0.000	0.000	0.000	0.000	0.000	0.000	0.000	0.000	0.000	0.000	0.000
WL Length m	20.400	20.400	20.400	20.400	20.400	20.400	20.400	20.400	20.400	20.400	20.400	20.400	20.400	20.400	20.400	20.400	20.400
Beam max extents on WL m	4.600	4.800	5.000	5.000	5.000	5.000	5.000	5.000	5.000	5.000	5.000	5.000	5.000	5.000	5.000	5.000	5.000
Wetted Area m ²	95.697	102.401	109.146	114.225	119.301	124.377	129.453	134.529	139.605	144.681	149.757	154.833	159.909	164.985	170.060	175.136	180.188
Waterpl. Area m ²	93.746	97.822	101.898	101.898	101.898	101.898	101.898	101.898	101.898	101.898	101.898	101.898	101.898	101.898	101.898	101.898	101.901
Prismatic coeff. (Cp)	0.999	0.999	0.999	0.999	0.999	0.999	0.999	0.999	0.999	0.999	0.999	0.999	0.999	0.999	0.999	0.999	0.999
Block coeff. (Cb)	0.713	0.801	0.829	0.867	0.891	0.908	0.920	0.929	0.936	0.942	0.947	0.951	0.955	0.958	0.961	0.963	0.965
Max Sect. area coeff. (Cm)	0.714	0.802	0.830	0.868	0.892	0.908	0.921	0.930	0.937	0.943	0.948	0.952	0.956	0.959	0.962	0.964	0.966
Waterpl. area coeff. (Cwp)	0.999	0.999	0.999	0.999	0.999	0.999	0.999	0.999	0.999	0.999	0.999	0.999	0.999	0.999	0.999	0.999	0.999
LCB from zero pt. (+ve fwd) m	10.200	10.200	10.200	10.200	10.200	10.200	10.200	10.200	10.200	10.200	10.200	10.200	10.200	10.200	10.200	10.200	10.200
LCF from zero pt. (+ve fwd) m	10.200	10.200	10.200	10.200	10.200	10.200	10.200	10.200	10.200	10.200	10.200	10.200	10.200	10.200	10.200	10.200	10.200
KB m	0.091	0.144	0.197	0.249	0.300	0.351	0.401	0.452	0.502	0.552	0.603	0.653	0.703	0.753	0.803	0.853	0.903
KG m	0.400	0.400	0.400	0.400	0.400	0.400	0.400	0.400	0.400	0.400	0.400	0.400	0.400	0.400	0.400	0.400	0.400
BMt m	16.470	9.575	7.172	5.335	4.247	3.528	3.017	2.635	2.340	2.103	1.910	1.750	1.614	1.498	1.398	1.310	1.232
BML m	324.239	173.123	119.500	88.898	70.774	58.789	50.275	43.915	38.983	35.048	31.834	29.160	26.900	24.966	23.291	21.826	20.535
GMt m	16.161	9.319	6.969	5.184	4.148	3.479	3.019	2.687	2.442	2.256	2.113	2.003	1.917	1.851	1.801	1.763	1.736
GML m	323.930	172.867	119.297	88.747	70.674	58.740	50.276	43.967	39.086	35.200	32.036	29.413	27.203	25.319	23.694	22.280	21.039
KMt m	16.561	9.719	7.369	5.584	4.548	3.879	3.419	3.087	2.842	2.656	2.513	2.403	2.317	2.251	2.201	2.163	2.136
KML m	324.330	173.267	119.697	89.147	71.074	59.140	50.676	44.367	39.486	35.600	32.436	29.813	27.603	25.719	24.094	22.680	21.439
Immersion (TPc) tonne/cm	0.961	1.003	1.044	1.044	1.044	1.044	1.044	1.044	1.044	1.044	1.044	1.044	1.044	1.044	1.044	1.044	1.044
MTc tonne.m	1.634	1.704	1.774	1.774	1.775	1.776	1.777	1.779	1.782	1.785	1.789	1.793	1.797	1.802	1.808	1.814	1.821
RM at 1deg = GMt.Disp.sin(1) tonne.m	2.902	3.270	3.690	3.690	3.708	3.745	3.799	3.872	3.963	4.073	4.200	4.346	4.510	4.693	4.893	5.112	5.349

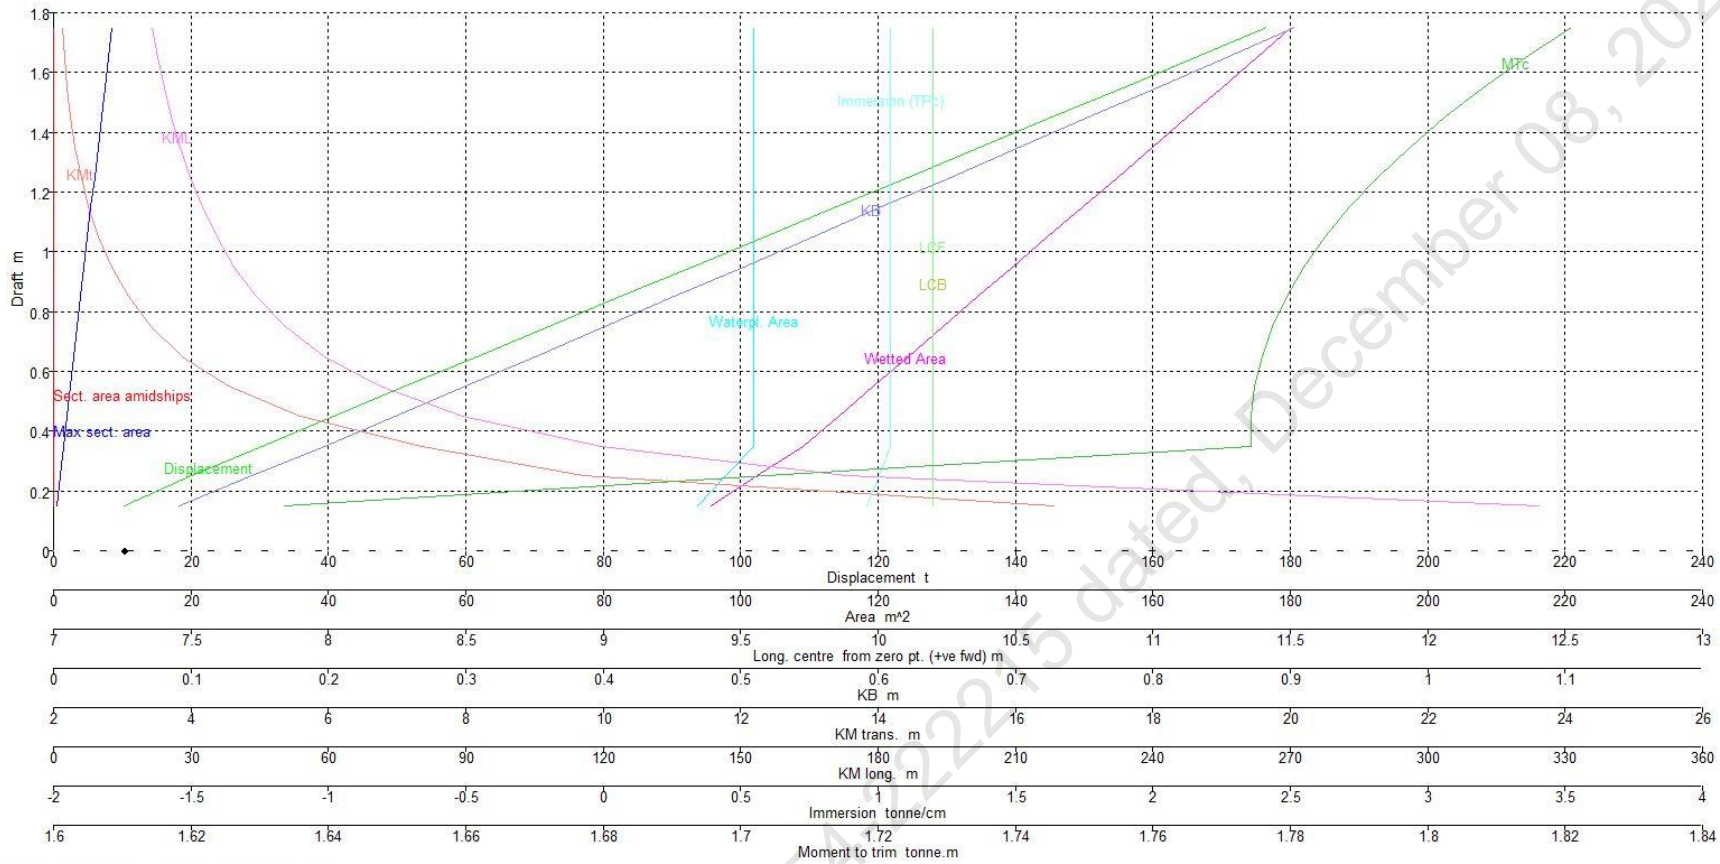

- Hydrostatics**
- Displacement
 - Max sect. area
 - Sect. area amidships
 - Wetted Area
 - Waterpl. Area
 - LCB
 - LCF
 - KB
 - KMT
 - KML
 - Immersion (TPC)
 - MTc

Draft = 0.000 m Displacement = 10.288 t

Refer IRS Letter E-166854 dated 08.12.2022

KN Calculation - patna-moored barge_R4

Case - Intact


Initial Trim = 0 m (+ve by stern)

Specific gravity = 1.025; (Density = 1.025 tonne/m³)

VCG = 0 m; TCG = 0 m

Displacement (intact) tonne	Draft Amidships m	Trim (+ve by stern) m	LCG m	TCG m	Assumed VCG m	KN 0.0 deg.	KN 5.0 deg. Starb.	KN 10.0 deg. Starb.	KN 15.0 deg. Starb.	KN 20.0 deg. Starb.	KN 25.0 deg. Starb.	KN 30.0 deg. Starb.	KN 35.0 deg. Starb.	KN 40.0 deg. Starb.	KN 45.0 deg. Starb.	KN 50.0 deg. Starb.	KN 60.0 deg. Starb.	KN 70.0 deg. Starb.	KN 80.0 deg. Starb.
10.00	0.147	0.000	10.200	0.000	0.000	0.000	1.078	1.523	1.735	1.845	1.897	1.913	1.902	1.870	1.820	1.756	1.597	1.424	1.226
30.00	0.347	0.000	10.200	0.000	0.000	0.000	0.612	1.077	1.344	1.518	1.637	1.716	1.766	1.794	1.802	1.784	1.671	1.481	1.235
50.00	0.538	0.000	10.200	0.000	0.000	0.000	0.406	0.790	1.102	1.315	1.470	1.588	1.668	1.704	1.708	1.687	1.584	1.416	1.197
70.00	0.730	0.000	10.200	0.000	0.000	0.000	0.306	0.615	0.909	1.157	1.341	1.457	1.523	1.555	1.562	1.548	1.470	1.334	1.153
90.00	0.921	0.000	10.200	0.000	0.000	0.000	0.254	0.511	0.772	1.019	1.188	1.290	1.353	1.388	1.403	1.400	1.350	1.251	1.109
110.0	1.113	0.000	10.200	0.000	0.000	0.000	0.224	0.450	0.681	0.871	1.008	1.106	1.171	1.214	1.239	1.249	1.231	1.168	1.066
130.0	1.304	0.000	10.200	0.000	0.000	0.000	0.206	0.413	0.590	0.723	0.830	0.915	0.984	1.036	1.072	1.096	1.111	1.085	1.023
150.0	1.496	0.000	10.200	0.000	0.000	0.000	0.195	0.361	0.481	0.578	0.663	0.736	0.801	0.856	0.902	0.939	0.987	1.000	0.979
170.0	1.687	0.000	10.200	0.000	0.000	0.000	0.157	0.261	0.350	0.429	0.503	0.571	0.633	0.691	0.743	0.789	0.864	0.913	0.935

Refer IRS Letter E-166854-222215 dated 08, 2022

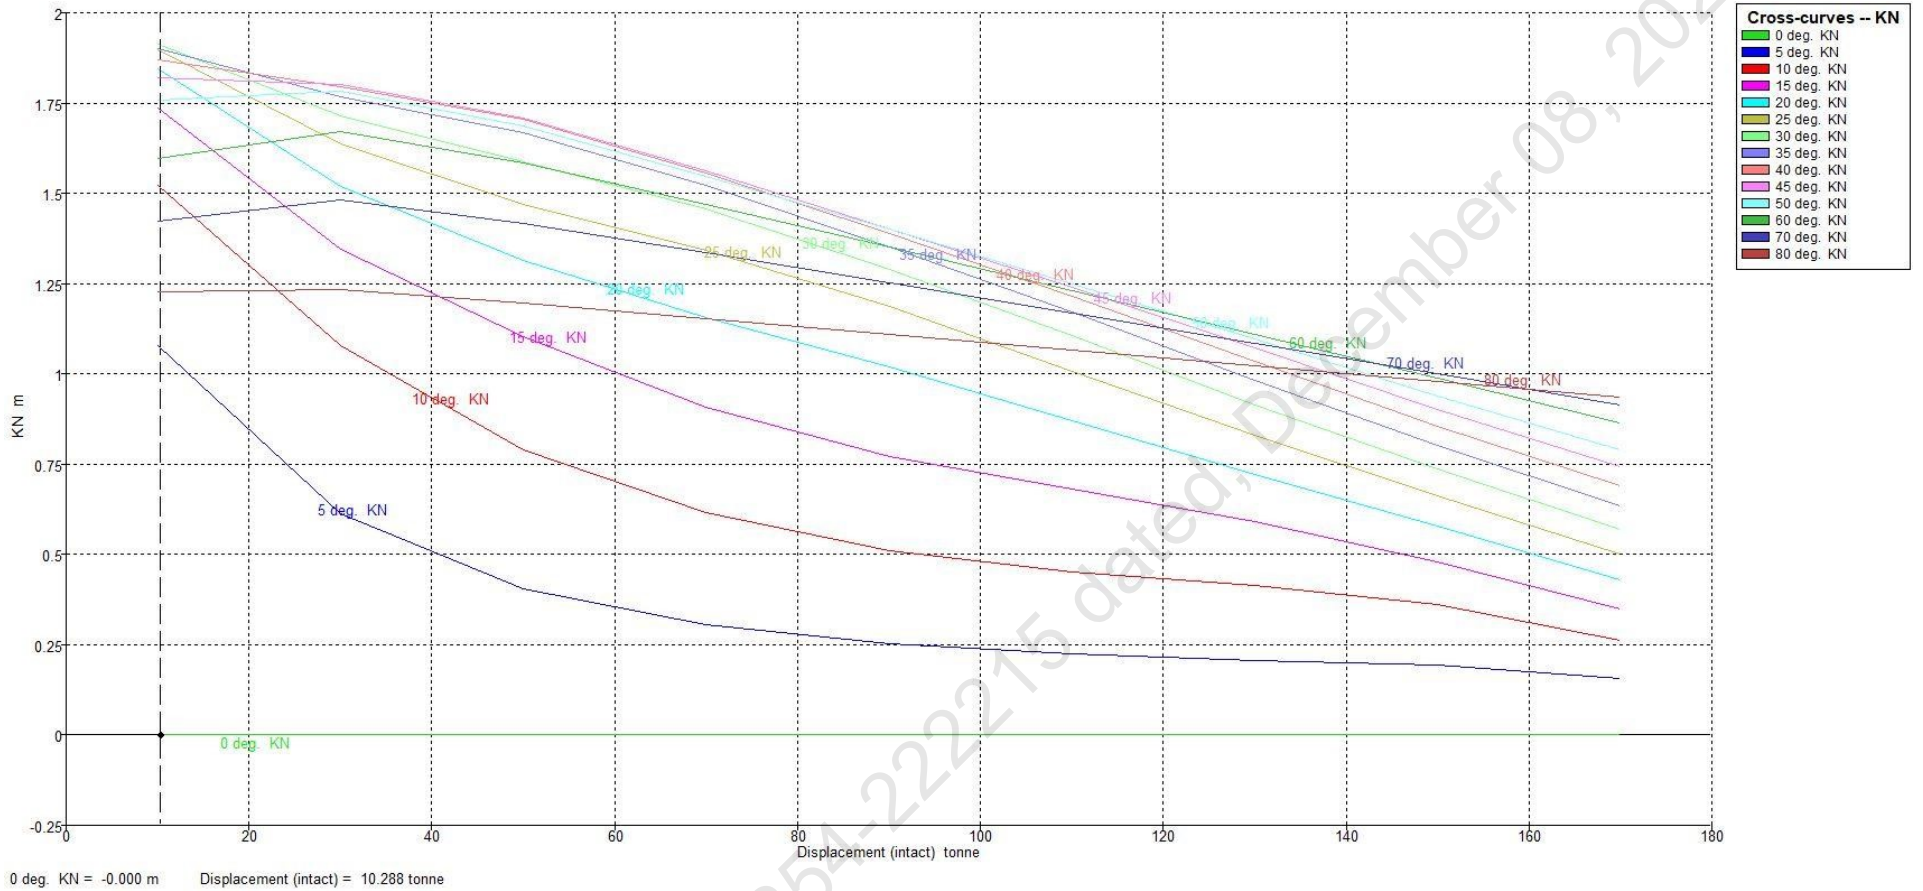

Refer IRS Letter E-166854-22215 dated, December 08, 2022

Equilibrium Calculation - patna-moored barge_R4

Loadcase 1 (without spuds)

Case - Intact

Free to Trim

Specific gravity = 1.025; (Density = 1.025 tonne/m³)

Fluid analysis method: Use corrected VCG

Item Name	Quantity	Unit Mass tonne	Total Mass tonne	Unit Volume m ³	Total Volume m ³	Long. Arm m	Trans. Arm m	Vert. Arm m	Total FSM tonne.m	FSM Type
Lightship	1	40.780	40.780			10.200	0.000	0.810	0.000	User Specified
Total Loadcase			40.780	0.000	0.000	10.200	0.000	0.810	0.000	
FS correction								0.000		
VCG fluid								0.810		

Draft Amidships m	0.450
Displacement t	40.78
Heel deg	0.0
Draft at FP m	0.450
Draft at AP m	0.450
Draft at LCF m	0.450
Trim (+ve by stern) m	0.000
WL Length m	20.400
Beam max extents on WL m	5.000
Wetted Area m ²	114.222
Waterpl. Area m ²	101.898
Prismatic coeff. (Cp)	0.999
Block coeff. (Cb)	0.867
Max Sect. area coeff. (Cm)	0.868
Waterpl. area coeff. (Cwp)	0.999
LCB from zero pt. (+ve fwd) m	10.200
LCF from zero pt. (+ve fwd) m	10.200
KB m	0.249
KG fluid m	0.810
BMT m	5.336
BML m	88.911
GMt corrected m	4.775
GML m	88.350
KMt m	5.585
KML m	89.160
Immersion (TPc) tonne/cm	1.044
MTc tonne.m	1.766
RM at 1deg = GMt.Disp.sin(1) tonne.m	3.398
Max deck inclination deg	0.0000
Trim angle (+ve by stern) deg	0.0000


Key point	Type	Freeboard m
Margin Line (freeboard pos = 0 m)		1.224
Deck Edge (freeboard pos = 0 m)		1.3
DF point1	Downflooding point	0.75
DF point2	Downflooding point	0.75
DF point3	Downflooding point	0.75
DF point4	Downflooding point	0.75
DF point5	Downflooding point	0.75
DF point6	Downflooding point	0.75

Stability Calculation - patna-moored barge_R4

Heel to Starboard deg	0.0	5.0	10.0	15.0	20.0	25.0	30.0	35.0	40.0	45.0	50.0	60.0	70.0	80.0
GZ m	0.000	0.410	0.771	0.995	1.123	1.198	1.237	1.249	1.236	1.190	1.121	0.929	0.688	0.418
Area under GZ curve from zero heel m.deg	0.0000	1.0294	4.0242	8.4953	13.8190	19.6380	25.7366	31.962	38.1894	44.2639	50.0563	60.3351	68.4612	74.0031
Displacement t	40.78	40.78	40.78	40.78	40.78	40.78	40.78	40.78	40.78	40.78	40.78	40.78	40.78	40.78
Draft at FP m	0.450	0.449	0.438	0.398	0.329	0.234	0.114	-0.035	-0.216	-0.426	-0.677	-1.390	-2.736	-6.622
Draft at AP m	0.450	0.449	0.438	0.398	0.329	0.234	0.114	-0.035	-0.216	-0.426	-0.677	-1.390	-2.736	-6.622
WL Length m	20.400	20.400	20.400	20.400	20.400	20.400	20.400	20.400	20.400	20.400	20.400	20.400	20.400	20.400
Beam max extents on WL m	5.000	4.908	4.565	3.937	3.552	3.301	3.115	2.991	2.733	2.513	2.369	2.110	1.868	1.780
Wetted Area m^2	114.222	113.432	108.531	98.236	92.221	88.443	85.667	83.826	83.379	83.190	82.923	82.591	82.407	82.316
Waterpl. Area m^2	101.898	100.028	93.036	80.234	72.386	67.266	63.485	60.946	55.695	50.792	46.831	41.354	38.063	36.282
Prismatic coeff. (Cp)	0.999	0.999	0.999	0.999	0.999	0.999	0.999	0.999	0.999	0.999	0.999	0.999	0.999	0.999
Block coeff. (Cb)	0.867	0.731	0.590	0.569	0.558	0.551	0.550	0.553	0.592	0.637	0.656	0.714	0.807	0.875
LCB from zero pt. (+ve fwd) m	10.200	10.200	10.200	10.200	10.200	10.200	10.200	10.200	10.200	10.200	10.200	10.200	10.200	10.200
LCF from zero pt. (+ve fwd) m	10.200	10.200	10.200	10.200	10.200	10.200	10.200	10.200	10.200	10.200	10.200	10.200	10.200	10.200
Max deck inclination deg	0.0000	5.0000	10.0000	15.0000	20.0000	25.0000	30.0000	35.0000	40.0000	45.0000	50.0000	60.0000	70.0000	80.0000
Trim angle (+ve by stern) deg	0.0000	0.0000	0.0000	0.0000	0.0000	0.0000	0.0000	0.0000	0.0000	0.0000	0.0000	0.0000	0.0000	0.0000

Key point	Type	Immersion angle deg	Emergence angle deg
Margin Line (immersion pos = 19.164 m)		33.7	n/a
Deck Edge (immersion pos = 19.164 m)		36.1	n/a
DF point1	Downflooding point	19.9	0
DF point2	Downflooding point	19.9	0
DF point3	Downflooding point	19.9	0
DF point4	Downflooding point	Not immersed in positive range	0
DF point5	Downflooding point	Not immersed in positive range	0
DF point6	Downflooding point	Not immersed in positive range	0

Code	Criteria	Value	Units	Actual	Status	Margin %
Intact	3.(a)i: Angle of max GZ	15.0	deg	35.5	Pass	+136.33
Intact	3.(a)ii: Value of max. GZ	0.200	m	1.122	Pass	+461.00
Intact	3.(b): Angle of downflooding	15.0	deg	19.9	Pass	+32.91
Intact	3.(c): GZ area between limits	3.7278	m.deg	13.7488	Pass	+268.82
Intact	3.(d): Initial GMt	0.150	m	4.775	Pass	+3083.33

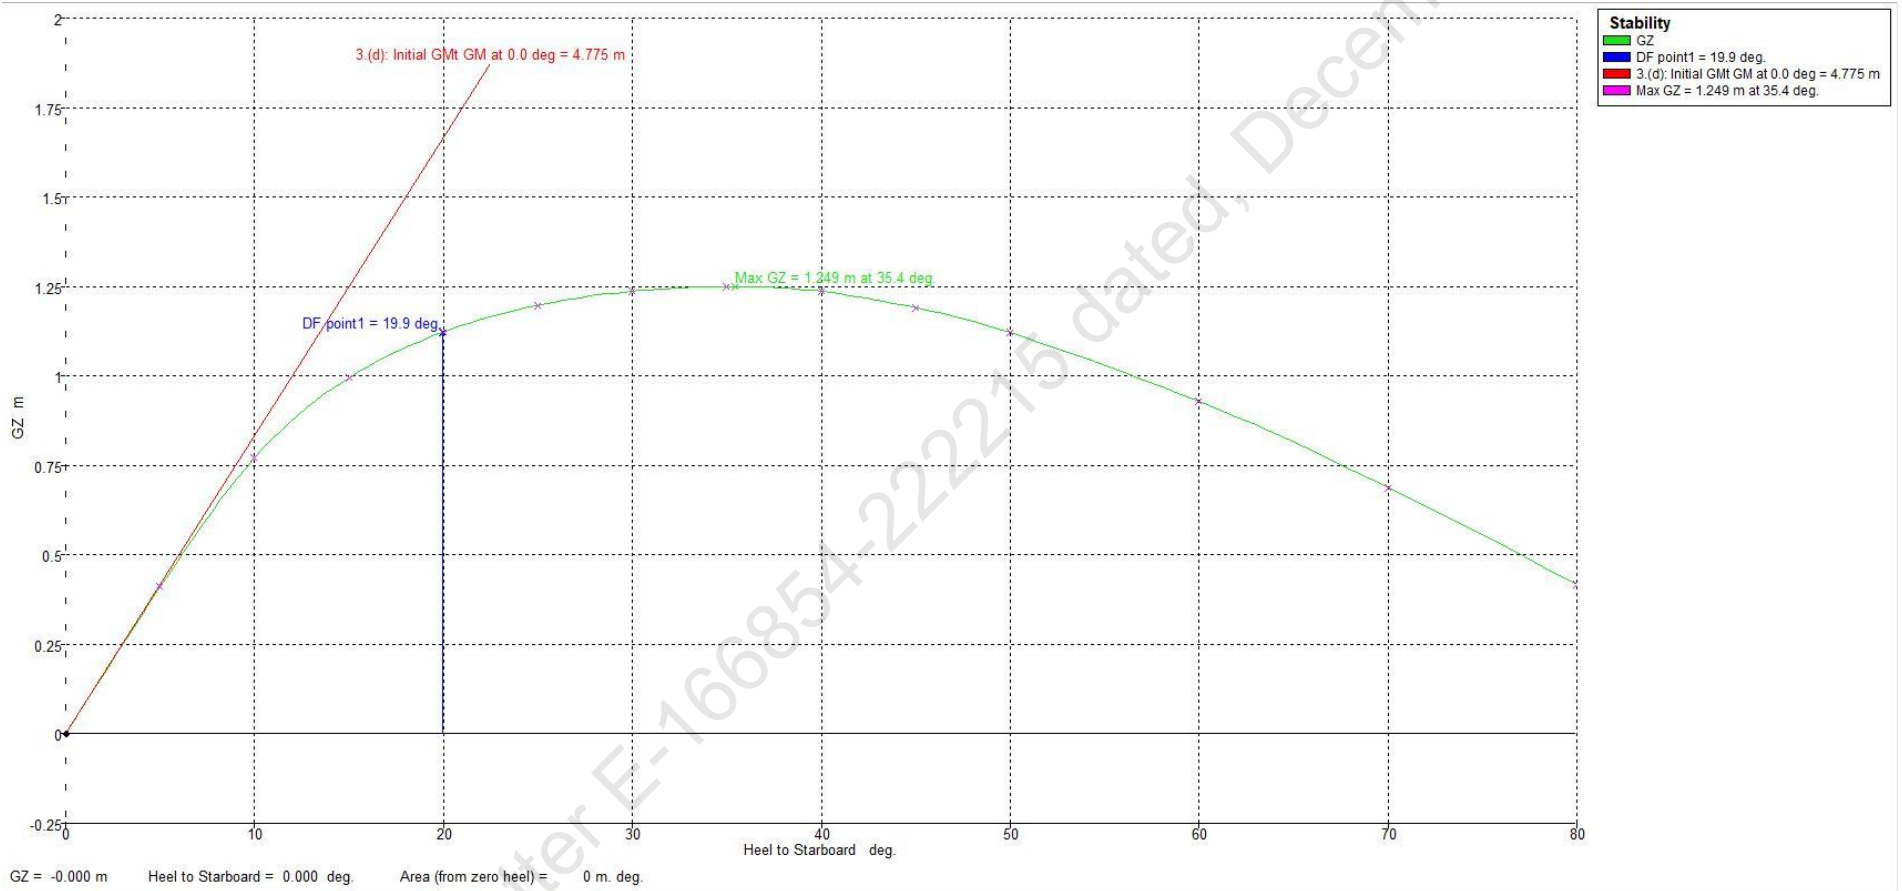

Refer IRS Letter E-166854-222715 dated, December 08, 2022

Stability Calculation - patna-moored barge_R4

Loadcase 2 (with spuds in upright position)

Damage Case - Intact

Free to Trim

Specific gravity = 1.025; (Density = 1.025 tonne/m³)


Fluid analysis method: Use corrected VCG

Item Name	Quantity	Unit Mass tonne	Total Mass tonne	Unit Volume m ³	Total Volume m ³	Long. Arm m	Trans. Arm m	Vert. Arm m	Total FSM tonne.m	FSM Type
Lightship	1	40.780	40.780			10.200	0.000	0.810	0.000	User Specified
spuds	4	1.600	6.400			10.200	0.000	3.000	0.000	User Specified
Total Loadcase			47.180	0.000	0.000	10.200	0.000	1.107	0.000	
FS correction								0.000		
VCG fluid								1.107		

Heel to Starboard deg	0.0	5.0	10.0	15.0	20.0	25.0	30.0	35.0	40.0	45.0	50.0	60.0	70.0	80.0
GZ m	0.000	0.330	0.632	0.846	0.961	1.023	1.050	1.049	1.010	0.943	0.856	0.640	0.386	0.112
Area under GZ curve from zero heel m.deg	0.0000	0.8277	3.2564	6.9944	11.5433	16.5188	21.7117	26.9721	32.1356	37.0255	41.5366	49.0433	54.2032	56.7015
Displacement t	47.18	47.18	47.18	47.18	47.18	47.18	47.18	47.18	47.18	47.18	47.18	47.18	47.18	47.18
Draft at FP m	0.511	0.511	0.504	0.476	0.417	0.333	0.224	0.088	-0.070	-0.252	-0.471	-1.090	-2.259	-5.635
Draft at AP m	0.511	0.511	0.504	0.476	0.417	0.333	0.224	0.088	-0.070	-0.252	-0.471	-1.090	-2.259	-5.635
WL Length m	20.400	20.400	20.400	20.400	20.400	20.400	20.400	20.400	20.400	20.400	20.400	20.400	20.400	20.400
Beam max extents on WL m	5.000	4.966	4.830	4.188	3.778	3.511	3.335	3.060	2.744	2.505	2.320	2.049	1.886	1.798
Wetted Area m ²	117.333	116.965	115.865	105.388	98.989	94.975	92.390	91.139	90.909	90.752	90.639	90.305	90.124	90.032
Waterpl. Area m ²	101.898	101.20	98.429	85.349	77.000	71.558	67.958	62.366	55.927	51.047	47.282	41.758	38.435	36.637
Prismatic coeff. (Cp)	0.999	0.999	0.999	0.999	0.999	0.999	0.999	0.999	0.999	0.999	0.999	0.999	0.999	0.999
Block coeff. (Cb)	0.883	0.750	0.592	0.570	0.559	0.553	0.549	0.576	0.625	0.671	0.701	0.762	0.821	0.882
LCB from zero pt. (+ve fwd) m	10.200	10.200	10.200	10.200	10.200	10.200	10.200	10.200	10.200	10.200	10.200	10.200	10.200	10.200
LCF from zero pt. (+ve fwd) m	10.200	10.200	10.200	10.200	10.200	10.200	10.200	10.200	10.200	10.200	10.200	10.200	10.200	10.200
Max deck inclination deg	0.0000	5.0000	10.000	15.0000	20.000	25.000	30.000	35.000	40.000	45.000	50.000	60.000	70.0000	80.0000
Trim angle (+ve by stern) deg	0.0000	0.0000	0.0000	0.0000	0.0000	0.0000	0.0000	0.0000	0.0000	0.0000	0.0000	0.0000	0.0000	0.0000

Key point	Type	Immersion angle deg	Emergence angle deg
Margin Line (immersion pos = 19.164 m)		30.2	n/a
Deck Edge (immersion pos = 19.164 m)		32.5	n/a

Code	Criteria	Value	Units	Actual	Status	Margin %
Intact	3.(a)i: Angle of max GZ	15.0	deg	32.3	Pass	+115.20
Intact	3.(a)ii: Value of max. GZ	0.200	m	1.053	Pass	+426.50
Intact	3.(b): Angle of downflooding	15.0	deg		Immersion angle not valid.	
Intact	3.(c): GZ area between limits	3.1513	m.deg	24.1104	Pass	+665.10
Intact	3.(d): Initial GMT	0.150	m	3.785	Pass	+2423.33
Intact	3.(e): Angle of equilibrium - multiple heeling arms				Pass	
	Passenger crowding (Hpc)	10.0	deg	0.4	Pass	+96.21
	Wind heeling (Hw)	10.0	deg	0.5	Pass	+95.25
	Hpc + Hw	12.0	deg	0.9	Pass	+92.88

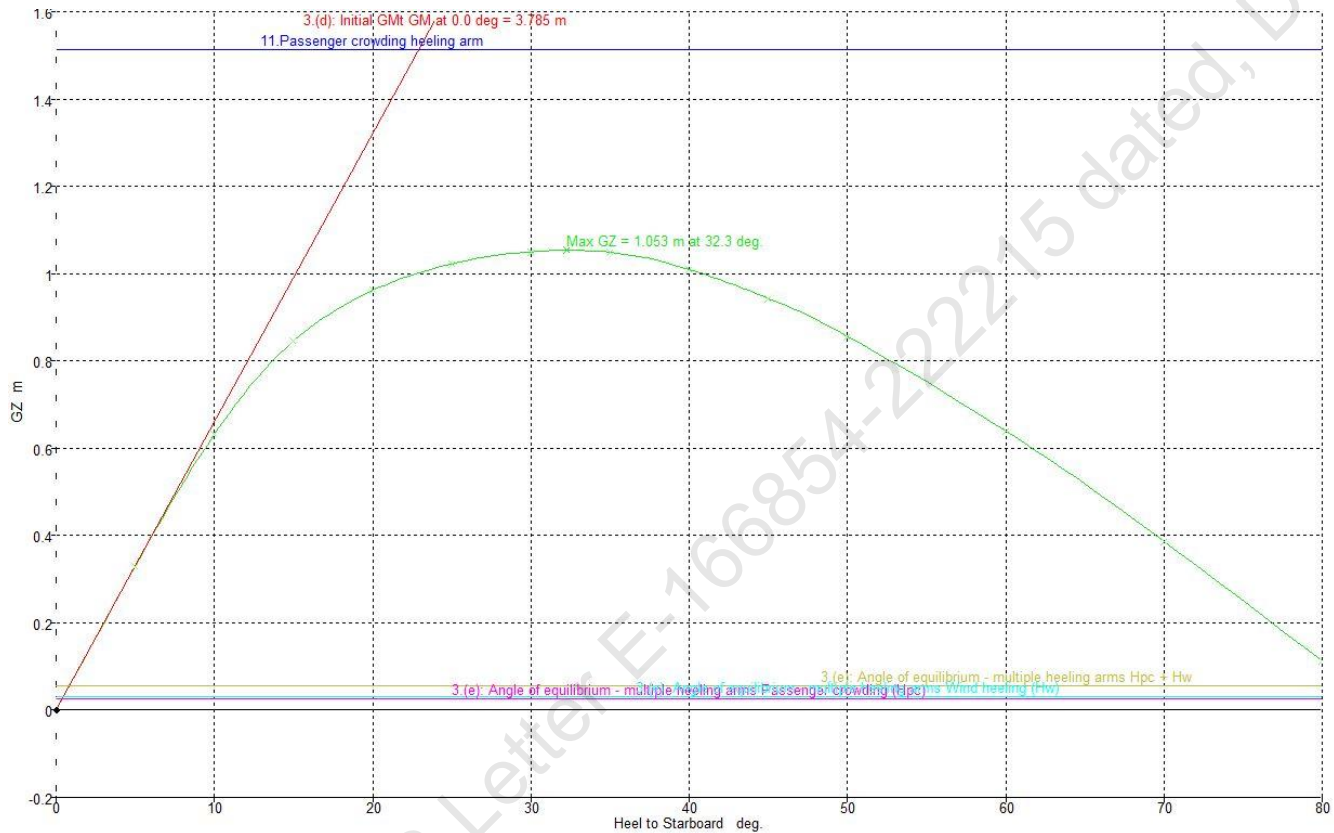

Stability

- GZ
- 11 Passenger crowding heeling arm
- 3.(d): Initial GMT GM at 0.0 deg = 3.785 m
- 3.(e): Angle of equilibrium - multiple heeling arms Passenger crowding (Hpc)
- 3.(e): Angle of equilibrium - multiple heeling arms Wind heeling (Hw)
- 3.(e): Angle of equilibrium - multiple heeling arms Hpc + Hw
- Max GZ = 1.053 m at 32.3 deg.

GZ = 0.000 m Heel to Starboard = 0.000 deg Area (from zero heel) = 0.000 m.deg

Refer IRS Letter E-166854-22 dated, December 08, 2022

TANK SOUNDINGS ARE NOT PART OF APPROVAL

	0.009	1.841	0.1	0.021	0.021	10.2	-0.244	0.005	0.074
	0	1.85	0	0	0	10.2	-0.2	0	0
2S(void)	1.85	0	100	20.857	21.378	10.2	1.214	0.931	0
	1.838	0.012	99.9	20.836	21.357	10.2	1.215	0.93	0.054
	1.718	0.132	95	19.814	20.31	10.2	1.226	0.887	6.38
	1.63	0.22	90	18.771	19.241	10.2	1.225	0.844	6.379
	1.543	0.307	85	17.728	18.172	10.2	1.223	0.8	6.379
	1.456	0.394	80	16.686	17.103	10.2	1.221	0.756	6.379
	1.369	0.481	75	15.643	16.034	10.2	1.219	0.712	6.379
	1.281	0.569	70	14.6	14.965	10.2	1.217	0.669	6.379
	1.194	0.656	65	13.557	13.896	10.2	1.215	0.625	6.379
	1.107	0.743	60	12.514	12.827	10.2	1.212	0.581	6.379
	1.02	0.83	55	11.471	11.758	10.2	1.208	0.537	6.379
	0.932	0.918	50	10.429	10.689	10.2	1.204	0.493	6.379
	0.845	1.005	45	9.386	9.62	10.2	1.199	0.449	6.379
	0.758	1.092	40	8.343	8.551	10.2	1.193	0.405	6.379
	0.67	1.18	35	7.3	7.482	10.2	1.184	0.361	6.379
	0.583	1.267	30	6.257	6.414	10.2	1.174	0.317	6.379
	0.496	1.354	25	5.214	5.345	10.2	1.158	0.273	6.379
	0.409	1.441	20	4.171	4.276	10.2	1.135	0.228	6.379
	0.321	1.529	15	3.129	3.207	10.2	1.098	0.182	6.161
	0.231	1.619	10	2.086	2.138	10.2	1.04	0.134	5.512
	0.138	1.712	5	1.043	1.069	10.2	0.913	0.084	4.888
	0.009	1.841	0.1	0.021	0.021	10.2	0.244	0.005	0.074
	0	1.85	0	0	0	10.2	0.2	0	0
3P(void)	1.85	0	100	34.035	34.886	16.5	-1.214	0.931	0
	1.838	0.012	99.9	34.001	34.851	16.5	-1.215	0.93	0.088
	1.718	0.132	95	32.333	33.142	16.5	-1.226	0.887	10.409
	1.63	0.22	90	30.632	31.397	16.5	-1.225	0.844	10.409
	1.543	0.307	85	28.93	29.653	16.5	-1.223	0.8	10.409
	1.456	0.394	80	27.228	27.909	16.5	-1.221	0.756	10.409
	1.369	0.481	75	25.526	26.164	16.5	-1.219	0.712	10.409
	1.281	0.569	70	23.825	24.42	16.5	-1.217	0.669	10.409
	1.194	0.656	65	22.123	22.676	16.5	-1.215	0.625	10.409
	1.107	0.743	60	20.421	20.932	16.5	-1.212	0.581	10.409

Refer IRP/2019/156/2021, 15th September 08, 2022

Refer IRS Letter E-166854-222215 dated December 08, 2022